

WELL PLUGGING RECORD

Give All Information Completely
Make Required Affidavit
Mail or Deliver Report to:
Conservation Division
State Corporation Commission
800 Biting Building
Wichita, Kansas


OR
FORMATION PLUGGING RECORD

Strike out upper line
when reporting plug-
ging of formations.

Location as "NE $\frac{1}{4}$ NW $\frac{1}{4}$ SW $\frac{1}{4}$ " or footage from lines. Graham County. Sec. 3 Twp. 9S Rge. 21W (E).....(W)
Lease Owner Continental Oil Co.

Lease Name Trembley Well No. 1
Office Address Ponca City, Oklahoma

Character of Well (completed as Oil, Gas or Dry Hole) Stratigraphic test
Date well completed July 23, 19 44
Application for plugging filed July 23, 19 44
Application for plugging approved July 23, 19 44
Plugging commenced July 23, 19 44
Plugging completed July 23, 19 44
Reason for abandonment of well or producing formation

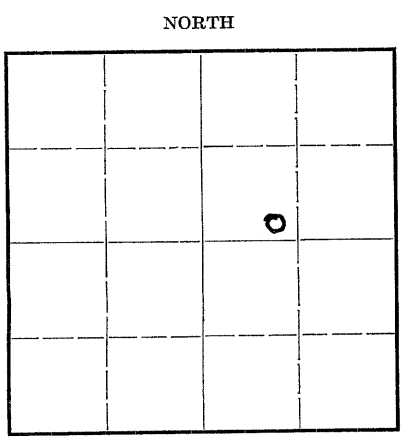

Locate well correctly on above Section Plat

If a producing well is abandoned, date of last production..... 19.....

Was permission obtained from the Conservation Division or its agents before plugging was commenced? Yes

Name of Conservation Agent who supervised plugging of this well Eldon Petty
Producing formation..... Depth to top..... Bottom..... Total Depth of Well..... Feet


Show depth and thickness of all water, oil and gas formations.
OIL, GAS OR WATER RECORDS

CASING RECORD

Formation	Content	From	To	Size	Put In	Pulled Out
				8 5/8"	128 ft.	none

Describe in detail the manner in which the well was plugged, indicating where the mud fluid was placed and the method or methods used in introducing it into the hold. If cement or other plugs were used, state the character of same and depth placed, from..... feet to..... feet for each plug set.

The hole was filled with heavy rotary mud to 250 feet where a wood plug was set and cemented with 15 sacks ~~of cement~~ of cement thru the drill pipe. The hole was then filled with mud to 30 feet where another plug was set and cemented to the top of the hole.

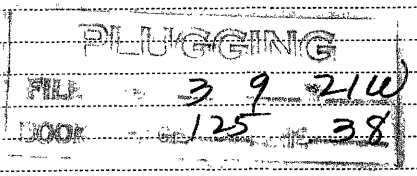

(If additional description is necessary, use BACK of this sheet)

Correspondence regarding this well should be addressed to J. George Klein
Address Box 120 Hays, Kansas

STATE OF Kansas, COUNTY OF Ellis,
J. George Klein (employee of owner) or (~~owner~~/operator) of the above-described well,

being first duly sworn on oath, says: That I have knowledge of the facts, statements, and matters herein contained and the log of the above-described well as filed and that the same are true and correct. So help me G^od.

(Signature) J. George Klein
Box 120 Hays, Kansas
(Address)

SUBSCRIBED AND SWORN to before me this 26th day of July 1944
Alvin M. Messinger
Notary Public.

My commission expires July 13, 1946