


WELL PLUGGING RECORD

Give All Information Completely  
Make Required Affidavit  
Mail or Deliver Report to:  
Conservation Division  
State Corporation Commission  
211 No. Broadway  
Wichita, Kansas

NORTH

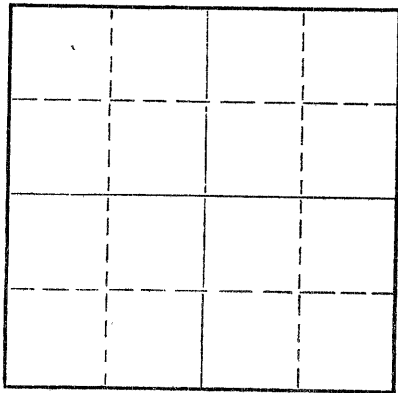

Locate well correctly on above  
Section Plat

Graham County. Sec. 3 Twp. 9S Rge. 21W (EX) (W)  
Location as "NE/CNW/SW" or footage from lines NW NE SE  
Lease Owner Three G Oil, Inc.  
Lease Name Herrold Well No. 1  
Office Address 1101 Wichita Plaza, Wichita, Kansas 67202  
Character of Well (completed as Oil, Gas or Dry Hole) Dry Hole  
Date well completed 4-17-67 19  
Application for plugging filed 4-17-67 19  
Application for plugging approved 4-17-67 19  
Plugging commenced 4-17-67 19  
Plugging completed 4-17-67 19  
Reason for abandonment of well or producing formation Dry Hole

If a producing well is abandoned, date of last production \_\_\_\_\_ 19\_\_\_\_  
Was permission obtained from the Conservation Division or its agents before plugging was commenced? yes

Name of Conservation Agent who supervised plugging of this well W. L. Nichols  
Producing formation \_\_\_\_\_ Depth to top \_\_\_\_\_ Bottom \_\_\_\_\_ Total Depth of Well 3737 Feet  
Show depth and thickness of all water, oil and gas formations.

OIL, GAS OR WATER RECORDS

CASING RECORD

FORMATION	CONTENT	FROM	TO	SIZE	PUT IN	PULLED OUT
				8 5/8"	249'	none

Describe in detail the manner in which the well was plugged, indicating where the mud fluid was placed and the method or methods used in introducing it into the hole. If cement or other plugs were used, state the character of same and depth placed, from \_\_\_\_\_ feet to \_\_\_\_\_ feet for each plug set.

Plug @ 550' with 20 sks. cem.  
Plug @ 240' with 20 sks. cem.  
1/2 sk. hulls & 10 sks. cem.

RECEIVED  
STATE CORPORATION COMMISSION  
4/20/67  
APR 20 1967

CONSERVATION DIVISION  
Wichita, Kansas

Name of Plugging Contractor Leben Drilling, Inc. (If additional description is necessary, use BACK of this sheet)  
Address Box 486, Great Bend, Kansas 67530

STATE OF KANSAS, COUNTY OF BARTON, ss.  
Leslie Kite

(employee of owner) or (owner or operator) of the above-described well, being first duly sworn on oath, says: That I have knowledge of the facts, statements, and matters herein contained and the log of the above-described well as filed and that the same are true and correct. So help me God.

(Signature) Leslie Kite  
Box 486, Great Bend, Kansas 67530  
(Address)

SUBSCRIBED AND SWORN TO before me this 19th day of April, 1967

My commission expires April 1, 1971  
Ulanda Nichols Notary Public.

DRILLER'S LOG

COMPANY: Three G Oil, Inc.  
 CONTRACTOR: LEBEN DRILLING, INC.  
 FARM: HERROLD #1  
 LOCATION: NW NE SE SEC. 3-9S-21W  
 GRAHAM COUNTY, KANSAS  
 COMMENCED: 4-8-67  
 COMPLETED: 4-17-67

0	125	Clay, Shale
125	249	Shale, Sand
249	1010	Shale
1010	1340	Sand, Shale
1340	1550	Redbed
1550	1630	Shale, Redbed
1630	1662	Anhydrite
1662	1980	Shale
1980	2240	Shale, Lime
2240	2688	Lime, Shale
2688	2890	Shale, Lime
2890	3222	Lime, Shale
3222	3737	Lime
	<u>3737</u>	<u>RTD - D. &amp; A.</u>

RECEIVED  
 STATE CORPORATION COMMISSION  
 APR 20 1967  
 CONSERVATION DIVISION  
 Wichita, Kansas

8 5/8" new 20# surface casing set @ 249' with 185 sacks Common, 2% cc

I, Leslie Kite, do hereby certify that the above and foregoing is a true and correct copy of the log of the Herrold #1 Well, located NW NE SE of Section 3, Township 9 South, Range 21 West, Graham County, Kansas, as reflected by the records of Leben Drilling, Inc.

Leslie Kite  
 Leslie Kite

STATE OF KANSAS )  
 ) SS  
 COUNTY OF BARTON )

Subscribed and sworn to and before me, a Notary Public, in and for Barton County, Kansas, this 19th day of April, 1967.

Ulanda Nichols  
 Ulanda Nichols

My Commission Expires:  
 April 1, 1971