


WELL PLUGGING RECORD

*Give All Information Completely
Make Required Affidavit
Mail or Deliver Report to:
Conservation Division
State Corporation Commission
211 No. Broadway
Wichita, Kansas

Graham County. Sec. 3 Twp. 9 Rge. 21 (E) (W)
Location as "NE/CNW%SW%" or footage from lines SE SE SE
Lease Owner Isern - Wells
Lease Name Herrold Well No. 1
Office Address P. O. Box 486 Ellinwood, Kansas
Character of Well (completed as Oil, Gas or Dry Hole) Dry Hole
Date well completed March 25 1963
Application for plugging filed March 26 1963
Application for plugging approved March 25 1963
Plugging commenced March 25 1963
Plugging completed March 25 1963
Reason for abandonment of well or producing formation Dry Hole

NORTH

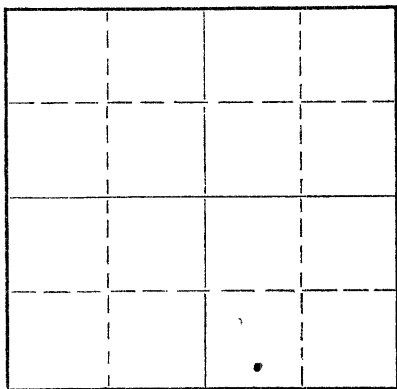

Locate well correctly on above
Section Plat

If a producing well is abandoned, date of last production _____ 19____
Was permission obtained from the Conservation Division or its agents before plugging was commenced? yes

Name of Conservation Agent who supervised plugging of this well W. L. Nichols
Producing formation _____ Depth to top _____ Bottom _____ Total Depth of Well 3741 Feet
Show depth and thickness of all water, oil and gas formations.

OIL, GAS OR WATER RECORDS

CASING RECORD

FORMATION	CONTENT	FROM	TO	SIZE	PUT IN	PULLED OUT

RECEIVED
STATE CORPORATION COMMISSION
3/28/63
MAR 28 1963
CONSERVATION DIVISION
Wichita, Kansas

Describe in detail the manner in which the well was plugged, indicating where the mud fluid was placed and the method or methods used in introducing it into the hole. If cement or other plugs were used, state the character of same and depth placed, from _____ feet to _____ feet for each plug set.

Set bottom plug 540' cemented with 20 sacks of cement.
2nd plug 270' cemented with 18 sacks of cement.
Top plug at 40' with 10 sacks of cement.
Dumped 1/4 sack hulls on the 270' and 1/4 sack hulls
on 40'. Two sacks cement in rat hole.
Under the supervision of W. L. Nichols.

(If additional description is necessary, use BACK of this sheet)
Name of Plugging Contractor Isern drilling Company
Address Box 486 Ellinwood, Kansas

STATE OF KANSAS, COUNTY OF BARTON, ss.
Richard Hogg (employee of owner) or (owner or operator) of the above-described well, being first duly sworn on oath, says: That I have knowledge of the facts, statements, and matters herein contained and the log of the above-described well as filed and that the same are true and correct. So help me God.

(Signature) R. H. Hogg
R. R. #1 Ellinwood, Kansas
(Address)

SUBSCRIBED AND SWORN TO before me this 27th day of March, 1963
I. J. Rader Notary Public.

My commission expires July 7, 1964.

3/28/63
6488-W

WELL LOG

ISERN, HERROLD #1 SE SE SE
Section 3-9-21
Graham County, Kansas

Figures indicate bottom of formation:

Elevation 2157' KB

PIPE RECORD
8 5/8" set at 268' with
200 sacks cement.

Rotary Commenced: 3-15-63
ROTARY COMPLETED: 3-23-63

GEOLOGICAL TOPS:

Topeka 3094
Heebner 3306
Lansing 3347
Chert Conglomerate 3626
Arbuckle 3711

0	to	10	cellar
		1850	shale & shells
		2050	lime & shales
		2255	shale shells
		2405	lime & shale
		2490	lime
		2645	shale & lime
		2755	lime & shale
		2835	lime
		2950	lime & shale
		3095	shale & lime
		3570	lime & shale
		3641	lime
		3741	Rotary Total Depth

RECEIVED
STATE CORPORATION COMMISSION

APR 5 1963

CONSERVATION DIVISION
Wichita, Kansas

STATE OF KANSAS)
) ss
COUNTY OF BARTON)

I, Richard Hogg, Drilling superintendent of the above-described well, being first duly sworn on oath, declare: That I have knowledge of the facts, statements and matter herein contained pertaining to the log of the above-described well, as filed, and that the same are true and correct.

Richard Hogg
Richard Hogg

Subscribed and sworn to before me this 28 day of March, 1963.

I. J. Rader
I. J. Rader, Notary Public

My Commission expires July 7, 1964.