

STATE OF KANSAS
STATE CORPORATION COMMISSION


WELL PLUGGING RECORD

Give All Information Completely
Make Required Affidavit
Mail or Deliver Report to:
Conservation Division
State Corporation Commission
800 Bitting Building
Wichita, Kansas

Graham County. Sec. 6 Twp. 9 Rge. 21 (E) (W)

Location as "NE/CNW/SW" or footage from lines NE SE SE
Lease Owner Stearns Petroleum, Inc.
Lease Name Fink Well No. 1
Office Address Box 313, Russell, Kansas
Character of Well (completed as Oil, Gas or Dry Hole) Dry Hole
Date well completed September 1 19 54
Application for plugging filed September 1 19 54
Application for plugging approved _____ 19 _____
Plugging commenced September 1 19 54
Plugging completed September 1 19 54
Reason for abandonment of well or producing formation _____

NORTH

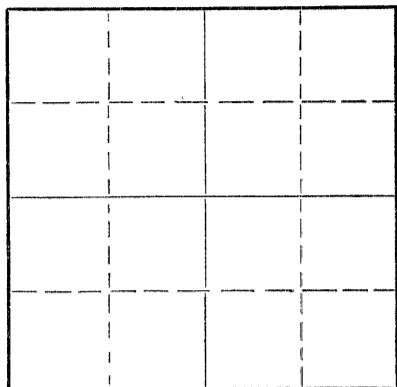

Locate well correctly on above
Section Plat

If a producing well is abandoned, date of last production _____ 19 _____
Was permission obtained from the Conservation Division or its agents before plugging was commenced? Yes

Name of Conservation Agent who supervised plugging of this well E. R. Petty, Hays, Kansas
Producing formation _____ Depth to top _____ Bottom _____ Total Depth of Well 3798 Feet
Show depth and thickness of all water, oil and gas formations.

OIL, GAS OR WATER RECORDS

CASING RECORD

FORMATION	CONTENT	FROM	TO	SIZE	PUT IN	PULLED OUT
				8 5/8	213'	---

Describe in detail the manner in which the well was plugged, indicating where the mud fluid was placed and the method or methods used in introducing it into the hole. If cement or other plugs were used, state the character of same and depth placed, from _____ feet to _____ feet for each plug set.

Plug at 200'; 15 sacks cement
Mud to 40'
Plug at 40'; 1/2 sack bf hulls; 10 sacks cement

(If additional description is necessary, use BACK of this sheet)

Name of Plugging Contractor Stearns Petroleum, Inc.
Address Box 313, Russell, Kansas

STATE OF Kansas, COUNTY OF Russell, ss.
D. G. Comstock (employee of owner) or (owner or operator) of the above-described well, being first duly sworn on oath, says: That I have knowledge of the facts, statements, and matters herein contained and the log of the above-described well as filed and that the same are true and correct. So help me God.

(Signature) *D. G. Comstock*
Russell, Kansas
(Address)

SUBSCRIBED AND SWORN TO before me this 10th day of September, 19 54

My commission expires May 26, 1958
Catherine J. ... Notary Public.

9/11/54

PLUGGING
INDEX SEC 6 T 9 R 21W
BOOK PAGE 61 LINE 37

FINK #1

Operator: Howard D. Fink, et al
 Contractor: Stearns Petroleum, Inc.
 Commencement Date: August 21, 1954
 Completion Date: September 2, 1954

LOCATION: NE NE SE
 Section 6-9S-21W
 Graham County, Kansas

Casing Record:

8 5/8" Set at 213' Cemented with 125 sacks.

WELL LOG

Cellar	0	5
Shale	5	220
Shale and Shells	220	752
Sand	752	812
Shale	812	980
Sand	980	1000
Shale and Sand	1000	1270
Sand	1270	1470
Shale	1470	1733
Anhydrite	1733	1762
Shale	1762	1850
Shale and Shells	1850	1925
Shale and Salt	1925	2140
Lime and Shale	2140	2185
Shale and Lime	2185	2690
Sand	2690	2710
Lime and Shale	2710	2825
Shale and Lime	2825	3265
Topeka	3172	
Lime and Shale	3265	3410
Heebner	3400	
Toronto	3431	
Lansing - Kansas City	3443	
Lime	3410	3652
Shale and Lime - Conglomerate	3652	3680
Shale and Lime	3680	3699
Lime	3699	3740
Shale	3740	3783
Arbuckle	3783	3798
Total Depth:	3798	

STATE OF KANSAS)
) SS:
 COUNTY OF RUSSELL)

I hereby certify that the above information is true and correct to the best of my knowledge.

Howard D. Fink

SUBSCRIBED AND SWORN to before me, a Notary Public, this 27 day of September, 1954.

Betty Paul Miller
 Notary Public

My Commission Expires:

April 5, 1958

