

STATE OF KANSAS
STATE CORPORATION COMMISSION

WELL PLUGGING RECORD

Give All Information Completely
Make Required Affidavit
Mail or Deliver Report to:
Conservation Division
State Corporation Commission
800 Bittling Building
Wichita, Kansas

Graham County, Sec. 4 Twp. 9S Rge. (E) 21 (W)

Location as "NE/CNW 1/4 SW 1/4" or footage from lines NE NE SW

Lease Owner Barnett Oil Company

Lease Name Napue Well No. 1

Office Address 417 First Natl. Bank Bldg., Wichita, Kansas

Character of Well (completed as Oil, Gas or Dry Hole) Dry Hole

Date well completed December 25, 1949

Application for plugging filed December 25, 1949

Application for plugging approved December 25, 1949


Plugging commenced December 25, 1949

Plugging completed December 25, 1949

Reason for abandonment of well or producing formation Dry Hole

If a producing well is abandoned, date of last production 19

Was permission obtained from the Conservation Division or its agents before plugging was commenced? Yes

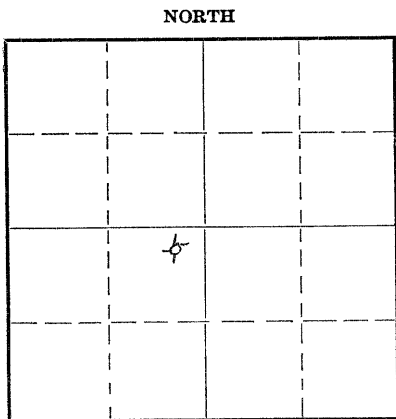

Locate well correctly on above Section Plat

Name of Conservation Agent who supervised plugging of this well C. D. Stough

Producing formation Depth to top Bottom Total Depth of Well 3742 Feet

Show depth and thickness of all water, oil and gas formations.

OIL, GAS OR WATER RECORDS

CASING RECORD

Formation	Content	From	To	Size	Put In	Pulled Out
		0	180	8 5/8"	180	None

Describe in detail the manner in which the well was plugged, indicating where the mud fluid was placed and the method or methods used in introducing it into the hole. If cement or other plugs were used, state the character of same and depth placed, from feet to feet for each plug set.

3742' - 181 1/2' - Heavy Rotary Mud
 181 1/2' - 180' - Wooden Plug
 180' - 134' - 15 sacks cement
 134' - 36 1/2' - Heavy Rotary Mud
 36 1/2' - 35' - Wooden Plug
 35' - 6' - 10 sacks cement
 6' - surface - cellar

RECORDED
1/15/50
STATION

(If additional description is necessary, use BACK of this sheet)

Correspondence regarding this well should be addressed to Peel-Hardman Producers
Address P.O. Box 359, Hoisington, Kansas

STATE OF Kansas, COUNTY OF Barton, ss.
Glenn Peel Drilling Co., Inc. (employee of owner) or (owner)

being first duly sworn on oath, says: That I have knowledge of the facts, statements, and matters herein contained and the log of the above-described well as filed and that the same are true and correct. So help me God. GLENN PEEL DRILLING CO., INC.

(Signature) BY: Mendell L. Peel

P.O. Box 359, Hoisington, Kansas (Address)

SUBSCRIBED AND SWORN to before me this 29th day of December, 1949

Commission expires June 4, 1951 Notary Public.

PLUGGING
FILE SEC 419 R 2112
BOOK PAGE 131 LINE 41

DRILLER'S LOG

Company: Barnett Oil Company
 Peel-Hardman Producers
 R. W. Shields

Sec. 4 Twp. 9S Rge: 21W
 NE NE SW

Farm: Napue Well No. 1

County: Graham,
 Kansas

Total Depth: 3742'
 Comm.: 12-15-49 Comp.: 12-25-49
 Contractor: Glenn Peel Drilling Co., Inc.
 Casing:
 8 5/8" 180' cem.

Elevation:
 Production: Dry

Figures below indicate bottom of formations

Surface Clay	0 -	40
Shale and Sand Streaks		100
Shale		181
Shale and Shells		610
Shale and Sand Streaks		1100
Sand		1320
Shale and Shells		1365
Red Bed and Shells		1595
Shale and Shells		1660
Anhydrite		1700
Shale and Shells		1945
Shale and Lime		2100
Lime and Shale		2400
Lime		2500
Lime and Shale		2645
Shale and Shells		2720
Lime and Shale		2990
Shale and Lime		3110
Lime and Shale		3315
Lime		3555
Lime and Shale		3720
Conglomerate		3730
Arbuckle Lime		3742
Total Depth		3742

This is to certify that the above information is, to the best of our knowledge, true and correct.

GLENN PEEL DRILLING COMPANY, INC.

BY: *Glenn Peel*

SUBSCRIBED AND SWORN to before me this 29th day of December, 1949.

My commission expires June 4, 1951

Marion M. Heber
 Notary Public

RECORDED
 DEC 4 9 21W
 INDEX PAGE 131 LINE 41

JAN 5 X 1950