

WELL PLUGGING RECORD

OR

FORMATION PLUGGING RECORD

Strike out upper line when reporting plugging of formations.

STATE OF KANSAS
 STATE CORPORATION COMMISSION
 Give All Information Completely
 Make Required Affidavit
 Mail or Deliver Report to:
 Conservation Division
 State Corporation Commission
 800 Bittling Building
 Wichita, Kansas

Graham County. Sec. 6 Twp. 9 Rge. 21 (E) 21 (W)

Location as "NE $\frac{1}{4}$ NW $\frac{1}{4}$ SW $\frac{1}{4}$ " or footage from lines NE NE SW $\frac{1}{4}$

Lease Owner M. B. Armer

Lease Name McSham Well No. 1

Office Address 306 Insurance Bldg., Wichita 2, Kansas

Character of Well (completed as Oil, Gas or Dry Hole) dry

Date well completed 10/18 19 48

Application for plugging filed 10/18 19 48

Application for plugging approved 10/18 19 48


Plugging commenced 10/19 19 48

Plugging completed 19

Reason for abandonment of well or producing formation dry

If a producing well is abandoned, date of last production 19

Was permission obtained from the Conservation Division or its agents before plugging was commenced? yes

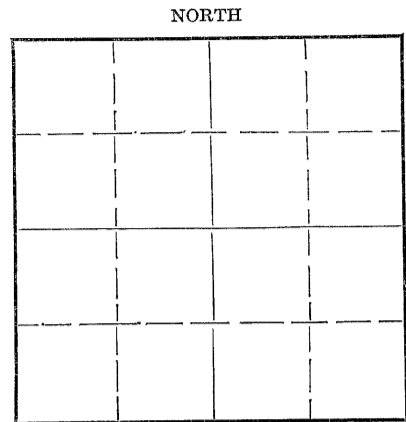

Locate well correctly on above Section Plat

Name of Conservation Agent who supervised plugging of this well M. A. Rives

Producing formation Arbuckle Depth to top 3792 Bottom 3842 Total Depth of Well 3842 Feet

Show depth and thickness of all water, oil and gas formations.

OIL, GAS OR WATER RECORDS

CASING RECORD

Formation	Content	From	To	Size	Put In	Pulled Out
Arbuckle	dry	3792	3842		KEE ZAP 180'	

Describe in detail the manner in which the well was plugged, indicating where the mud fluid was placed and the method or methods used in introducing it into the hole. If cement or other plugs were used, state the character of same and depth placed, from _____ feet to _____ feet for each plug set.

Mud to 170' - plug cement to 20', plug 10 sack cement to top

10/21/48

(If additional description is necessary, use BACK of this sheet)

Correspondence regarding this well should be addressed to M. B. Armer
 Address 306 Insurance Bldg., Wichita 2, Kansas

STATE OF Kansas, COUNTY OF Sedgwick, ss.

M. B. Armer (owner or operator) of the above-described well,

being first duly sworn on oath, says: That I have knowledge of the facts, statements, and matters herein contained and the log of the above-described well as filed and that the same are true and correct. So help me God.

(Signature) *M. B. Armer*

306 Insurance Bldg., Wichita 2, Kansas (Address)

SUBSCRIBED AND SWORN to before me this 20th day of October, 19 48.

Hazel Swanton
 Notary Public.

My commission expires Sept. 17, 1951

PLUGGING 22-2025 2-48-15M
 FILE SEC 6 T 9 R 21 W
 BOOK PAGE 63 LINE 5

Company: M. B. Armer
Contractor: Armer Drilling
Company, Inc.
Drilling Commenced: 10/3/48
Drilling Completed: 10/18/48
Elevation: 2221 D. F.
(Rotary Rig #2)

Farm: McShann #1
Location: NE NE SW¹/₄ Sec. 6-9-21
Graham County, Kansas

8" set @ 180

(Figures below indicate bottom)

Surface soil & sand	65
Shale & shells	180
Shale, shells & sand	300
Shale	675
Shale & shells	725
Sand	755
Shale & shells	1160
Shale, shells & Red Bed	1465
Anhydrite	1470
Shale, shells & Red Bed	1625
Shale & shells	1730
Anhydrite	1755
Shale	1790
Shale & shells	2225
Lime, shells & shale	2285
Shale & lime	2485
Lime	2545
Shale & shells	2785
Lime & shale	2855
Lime	3680
Lime & shale	3792
Lime - Arbuckle	3842 - Total Depth - D & A


TOPS:	
Heebner	3408'
Brown lime	3437'
Lansing	3449'
Arbuckle	3792'

I hereby certify that this is a true and correct log of the above described well as shown by the drilling reports.

ARMER DRILLING COMPANY, INC.

By M. B. Armer

STATE OF KANSAS)
) SS
COUNTY OF SEDGWICK)

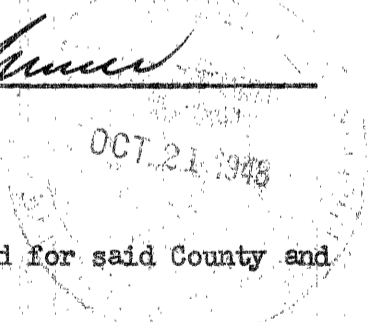

Subscribed and sworn to before me, a notary public, in and for said County and State this 20th day of October, 1948.

Hazel Walton
Notary Public.

My commission expires Sept. 17, 1951.

PLUGGING
FILE SEC 6 T 9 R 21 W
BOOK PAGE 63 LINE 5