


STATE OF KANSAS  
STATE CORPORATION COMMISSION  
Give All Information Completely  
Make Required Affidavit  
Mail or Deliver Report to:  
Conservation Division  
State Corporation Commission  
212 North Market, Insurance Bldg.  
Wichita, Kansas

**WELL PLUGGING RECORD**

Rooks County. Sec. 35 Twp. 9 Rge. (E) 20 (W)

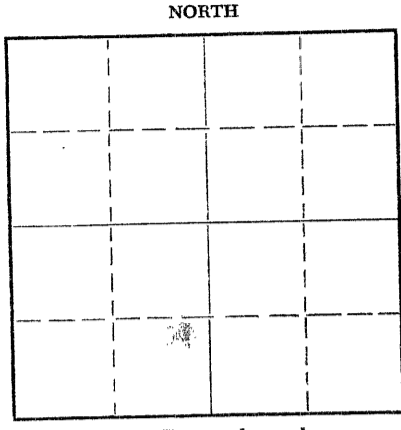

Locate well correctly on above Section Plat

Location as "NE/CNW/SW" or footage from lines NE SW NW  
Lease Owner American Petrofina Company of Texas  
Lease Name Allphin Well No. 2  
Office Address Box 209 Russell, Kansas  
Character of Well (completed as Oil, Gas or Dry Hole) Oil  
Date well completed 8-24 1954  
Application for plugging filed 6-29 1960  
Application for plugging approved 6-30 1960  
Plugging commenced 7-5 1960  
Plugging completed 7-6 1960  
Reason for abandonment of well or producing formation Insufficient Production

If a producing well is abandoned, date of last production August 1 1958

Was permission obtained from the Conservation Division or its agents before plugging was commenced? yes

Name of Conservation Agent who supervised plugging of this well Eldon Petty  
Producing formation Arbuckle Depth to top 3846 Bottom 3849 Total Depth of Well 3849 Feet  
Show depth and thickness of all water, oil and gas formations.

**OIL, GAS OR WATER RECORDS**

**CASING RECORD**

| FORMATION | CONTENT | FROM | TO        | SIZE   | PUT IN    | PULLED OUT |
|-----------|---------|------|-----------|--------|-----------|------------|
|           |         | 0    | 240'      | 8 5/8" | 240'      | 0          |
|           |         | 0    | 3846 1/2' | 5 1/2" | 3846 1/2' | 0          |
|           |         |      |           |        |           |            |
|           |         |      |           |        |           |            |
Describe in detail the manner in which the well was plugged, indicating where the mud fluid was placed and the method or methods used in introducing it into the hole. If cement or other plugs were used, state the character of same and depth placed, from \_\_\_\_\_ feet to \_\_\_\_\_ feet for each plug set.

Pumped 35 sacks of mud in hole  
Pumped 70 sacks of cement in hole.

**RECEIVED**  
STATE CORPORATION COMMISSION  
JUL 19 1960  
7-19-60  
CONSERVATION DIVISION  
Wichita, Kansas

(If additional description is necessary, use BACK of this sheet)  
Name of Plugging Contractor C. E. Skull Casing Pulling Company  
Address Box 558 Great Bend, Kansas

STATE OF KANSAS COUNTY OF RUSSELL, ss.  
LEVI B. SHERMAN (employee of owner) or (owner or operator) of the above-described well, being first duly sworn on oath, says: That I have knowledge of the facts, statements, and matters herein contained and the log of the above-described well as filed and that the same are true and correct. So help me God.

(Signature) Levi B. Sherman  
Box 209 = Russell, Kansas  
(Address)

SUBSCRIBED AND SWORN TO before me this 18th day of July, 19 60

Carol J. Bennett  
Notary Public.

My commission expires 10-2-60



WELL LOG-----ALPHIN #2

Location: NE SW NW, Section 35-9s-20w  
Rooks County, Kansas

OWNER: American Petrofina Company of Texas  
ROTARY DRILLING CONTRACTOR: Group Exploration Company

COMMENCED: 8-10-54 (w.r.)  
COMPLETED: 8-20-54 (w.r.)

TOTAL DEPTH: 3852' (w.r.)

LOG

CASING RECORD

|           |                  |
|-----------|------------------|
| 0-60      | Clay & Sand      |
| 60-910    | Shale            |
| 910-1150  | sand and shells  |
| 1150-1550 | Shale            |
| 1550-1730 | Shale and Shells |
| 1730-1910 | Shale            |
| 1910-2525 | Shale & Lime     |
| 2525-2630 | Sandy Lime       |
| 2630-2760 | Lime             |
| 2760-2900 | Shale & Lime     |
| 2900-3060 | Lime             |
| 3060-3515 | Lime & Shale     |
| 3515-3770 | Lime             |
| 3770-3820 | Lime & Shale     |
| 3820-3849 | Shale            |
| 3849-3852 | Lime Arb., T.D.  |

Ran 210' of 8 5/8" casing, set with 150 sacks of cement.

Ran 3851.67' of 5 1/2" casing, cemented with 50 sacks of cement.

**RECEIVED**  
 STATE OIL AND GAS COMMISSION  
 JUN 30 1960  
 6-30-60  
 CONSERVATION DIVISION  
 Wichita, Kansas

NOTE: Squeezed Dakota break in at 1165' with 265 sacks of cement.

Brief Plugging Record on  
American Petrofina Co. of Texas's  
Allphin Well #2, in  
Rooks County, Kansas

---

15-163-01781-00-01

Total depth 3852'

5½" casing set at 3854.67'

Cemented with 50 sacks

8 5/8" casing set at 240'

Cemented with 150 sacks

Squeezed Dakota break in at 1165'

With 265 sacks of cement

Pumped 35 sacks of mud in hole

Pumped 70 sacks of cement in hole

**RECEIVED**  
STATE CORPORATION COMMISSION

JUL 19 1960

CONSERVATION DIVISION  
Wichita, Kansas

Work started July 5, 1960

Work completed July 6, 1960

C. E. Shull Casing Pulling Company  
Box 558  
Great Bend, Kansas

License No. 8