


STATE OF KANSAS
STATE CORPORATION COMMISSION

WELL PLUGGING RECORD

Give All Information Completely
Make Required Affidavit
Mail or Deliver Report to
Conservation Division
State Corporation Comm.
245 North Water
Wichita, KS 67202

Rooks County. Sec. 35 Twp. 9 Rge. 20 XVW
Location as "NE/CNW $\frac{1}{4}$ SW $\frac{1}{4}$ " or footage from lines _____
C SW NW
Lease Owner I. O. Miller, Inc.
Lease Name Allphin Well No. 1
Office Address Box 124, Ellis, KS 67637
Character of Well (Completed as Oil, Gas or Dry Hole) _____

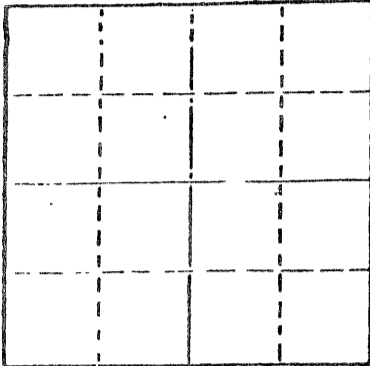

Locate well correctly on above
Section Plat

Dry Hole
Date Well completed 9-7 1978
Application for plugging filed 9-7 1978
Application for plugging approved 9-7 1978
Plugging commenced 9-7 1978
Plugging completed 9-7 1978
Reason for abandonment of well or producing formation _____

Dry Hole
If a producing well is abandoned, date of last production _____ 19____

Was permission obtained from the Conservation Division or its agents before plugging was commenced? yes

Name of Conservation Agent who supervised plugging of this well Gilbert Balthazor
Producing formation _____ Depth to top _____ Bottom _____ Total Depth of Well 3860'
Show depth and thickness of all water, oil and gas formations.

OIL, GAS OR WATER RECORDS

CASING RECORD

FORMATION	CONTENT	FROM	TO	SIZE	PUT IN	PULLED OUT
Surface Pipe				8 5/8"	168'	0'

Describe in detail the manner in which the well was plugged, indicating where the mud fluid was placed and the method or methods used in introducing it into the hold. If cement or other plugs were used, state the character of same and depth placed, from _____ feet to _____ feet for each plug set.

- 1st plug was set @ 750' w/70 sacks cement
- 2nd plug was set @ 160' w/20 sacks cement
- 3rd plug was set @ 40' w/10 sacks cement

(If additional description is necessary, use BACK of this sheet)

Name of Plugging Contractor Dreiling Oil, Inc.

STATE OF KANSAS COUNTY OF ELLIS, ss.
I, Joseph A. Hess, Sec. Treas. of Drlg. Contrc. (employee of owner) or (owner or operator) of the above-described well, being first duly sworn on oath, says: That I have knowledge of the facts, statements, and matters herein contained and the log of the above-described well as filed and that the same are true and correct. So help me God.

(Signature) Joseph A. Hess
JOSEPH A. HESS, HAYS, KS 67601
(Address)

SUBSCRIBED AND SWORN TO before me this 18th day of September, 1978

Cecilia Basgall
Cecilia Basgall Notary Public.

My commission expires November 17, 1980.

CECILIA BASGALL
NOTARY PUBLIC
Ellis County, Kansas

RECEIVED
STATE CORPORATION COMMISSION

SEP 19 1978
9-19-78
CONSERVATION DIVISION
Wichita, Kansas

DREILING OIL, INC.

15-103-20839-00-06

Victoria, Kansas 67671

WELL LOG

Company	I. O. Miller, Inc. Box 124 Ellis, KS 67637		Sec. 35	Twp. 9	Eng. 20
Farm	Allphin	No. 1	Location C SW NW		
Total Depth	3,860'		County Rooks		
Comm.	9-1-78	Comp. 9-7-78	Elevation:	2070	K. B.
Contractor	Dreiling Oil, Inc. Rt. #1 Victoria, KS 67671			2067	D. F.
				2065	G. R.

Casing Record
168' - 8 5/8"

Cement Record
150 sacks cement


Production:
D & A

Figures Indicate Bottom of Formations

0'	100'	Top Soil - Sand
100'	888'	Shale
888'	1014'	Sand
1014'	1488'	Shale & Sand
1488'	1733'	Shale-Sand-Red Bed
1733'	1767'	Anhydrite
1767'	2417'	Shale
2417'	3353'	Shale & Lime
3353'	3450'	Lime & Shale
3450'	3840'	Lime
3840'	3860'	Lime
3860'	T.D.	

STATE OF KANSAS)
)ss
COUNTY OF ELLIS)

I, Joseph A. Hess, Secretary Treasurer of Dreiling Oil, Inc., upon oath states that the above and foregoing is a true and correct copy from the Daily Drilling Report from the Allphin #1.

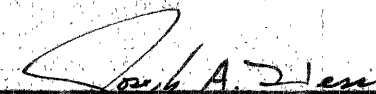
JOSEPH A. HESS

Subscribed and sworn to before me this 18th day of September, 1978.


Cecilia Basgall Notary Public

CECILIA BASGALL
NOTARY PUBLIC
Ellis County, Kansas

My appointment expires: November 17, 1980.

RECEIVED
STATE COMMISSIONER OF GEOL.

SEP 19 1978

CONFIDENTIAL
1414