


STATE OF KANSAS
STATE CORPORATION COMMISSION

Give All Information Completely
Make Required Affidavit
Mail or Deliver Report to:
Conservation Division
State Corporation Commission
800 Bitting Building
Wichita, Kansas

WELL PLUGGING RECORD

NORTH

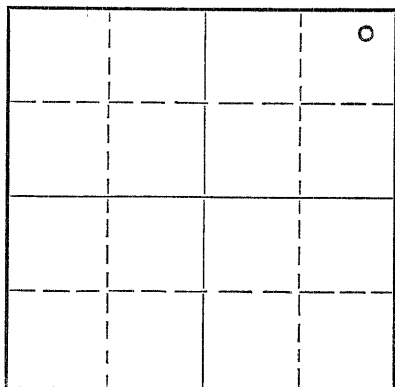

Locate well correctly on above
Section Plat

Rooks County. Sec. 35 Twp. 9 Rge 20W ~~NE~~ W (W)
Location as "NE/CNW $\frac{1}{4}$ SW $\frac{1}{4}$ " or footage from lines NE NE NE
Lease Owner L. O. MILLER
Lease Name PYWELL Well No. 1
Office Address P. O. Box 74, Ellis, Kansas
Character of Well (completed as Oil, Gas or Dry Hole) Dry Hole
Date well completed January 20, 1952
Application for plugging filed January 20, 1952
Application for plugging approved January 20, 1952
Plugging commenced January 20, 1952
Plugging completed January 20, 1952
Reason for abandonment of well or producing formation too low structurally.

If a producing well is abandoned, date of last production _____ 19____
Was permission obtained from the Conservation Division or its agents before plugging was commenced? yes

Name of Conservation Agent who supervised plugging of this well Eldon Petty, Hays, Kansas.
Producing formation _____ Depth to top _____ Bottom _____ Total Depth of Well _____ Feet
Show depth and thickness of all water, oil and gas formations.

OIL, GAS OR WATER RECORDS

CASING RECORD

Formation	Content	From	To	Size	Put In	Pulled Out
				8 5/8" (24#)	254.68'	

Describe in detail the manner in which the well was plugged, indicating where the mud fluid was placed and the method or methods used in introducing it into the hole. If cement or other plugs were used, state the character of same and depth placed, from _____ feet to _____ feet for each plug set.

Filled with drilling mud to 240', set plug. Put in 1/2 sack hulls and 15 sacks cement, then pumped full of mud to 40' from top of hole. Drove plug, then filled to top with 10 sacks of cement.

(If additional description is necessary, use BACK of this sheet)

Name of Plugging Contractor C-G Drilling Co.
Address 206 Union National Bank Bldg., Wichita, Kansas.

STATE OF KANSAS, COUNTY OF SEDGWICK, ss.
R. A. COOK


(Signature of owner or (owner or operator) of the above-described well,
being first duly sworn on oath, says: That I have knowledge of the facts, statements, and matters herein contained and the log of the above-described well as filed and that the same are true and correct. So help me God.

(Signature) R A Cook

206 Union National Bank Bldg.
(Address)

SUBSCRIBED AND SWORN to before me this 21st day of January, 1952.

My commission expires November 21, 1955
Marilyn Schmitt Notary Public.

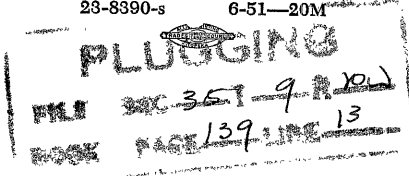

1-22-52

CONTRACTOR'S WELL LOG

Operator I. O. MILLER Farm Name Pywell #1
 Location NE NE NE Sec. 35-9-20W
 Pool Name W. C. County Rooks State Kansas
 Commencement Date January 8, 1952 Completion Date January 20, 1952

LOG OF WELL

Elevation 2245' R.B.
 All Measurements from the top of rotary bushing.

DEPTH		FORMATION	DEVIATION FROM VERTICAL
FROM	TO		
0	254		
254	870	Sand-Shale	
870	960	Sand	
960	1160	Sand-Shale	
1160	1415	Sand	
1415	1683	Red Bed	1500-0°
1683	1720	Anhydrite	
1720	1900	Shale	
1900	2265	Shale-Lime	2000-0°
2265	2385	Lime-Shale	
2385	2535	Lime-Shale	2500-0°
2535	2660	Lime-Shale	
2660	2810	Lime-Shale	
2810	2885	Lime-Shale	
2885	2990	Lime-Shale	
2990	3075	Lime-Shale	3000-0°
3075	3165	Lime-Shale	
3165	3280	Lime-Shale	
3280	3385	Lime-Shale	
3385	3430	Lime-Shale	
3430	3495	Lime-Shale	
3495	3540	Lime	3500-0°
3540	3585	Lime	
3585	3630	Lime	
3630	3675	Lime	
3675	3725	Lime	
3725	3788	Lime	
3788	3800	Chert	
3800	3805	Chert	
3805	3813	Chert	
3813	3825	Chert	
3825	3841	Lime-Shale	
3841	3865	Shale	
3865	3900	Lime-Shale	
3900		T. D.	

CASING LEFT IN HOLE AFTER COMPLETION

Ran 254.68' (18 jts.) of 8 5/8" casing.

STATE OF KANSAS, COUNTY OF SEDGWICK) SS

The undersigned certifies that to the best of his knowledge and belief, the above facts are true and correct.

PLUGGING
 FILE SEC 35 9 20W

C-G DRILLING CO.

By R. A. Cook

Subscribed and sworn to before me this 21st day of January, 1952

My commission expires: November 21, 1955.

Marilyn Schmidt
 Notary Public