

WELL PLUGGING RECORD

Give All Information Completely
Make Required Affidavit
Mail or Deliver Report to:
Conservation Division
State Corporation Commission
212 No. Market
Wichita, Kansas

Rooks County. Sec. 35 Twp. 9S Rge. 20 (E) W (W)

Location as "NE/CNW%SW%" or footage from lines NW NW NW

Lease Owner I. O. Miller

Lease Name Pywell Well No. 1

Office Address Wichita, Kansas 67202

Character of Well (completed as Oil, Gas or Dry Hole)

Date well completed Appx. March 10, 1953 19

Application for plugging filed 19

Application for plugging approved March 13 19 68


Plugging commenced 3/8/68 19

Plugging completed 3/12/68 19

Reason for abandonment of well or producing formation depleted.

If a producing well is abandoned, date of last production About 2-1-68. 19

Was permission obtained from the Conservation Division or its agents before plugging was commenced? Yes

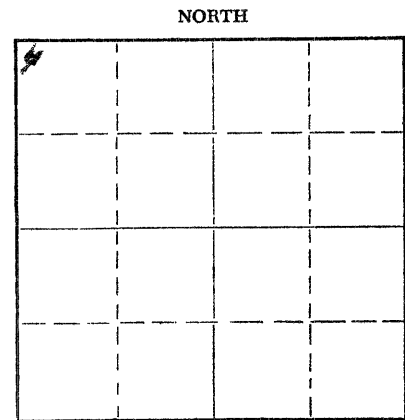

Locate well correctly on above Section Plat

Name of Conservation Agent who supervised plugging of this well Massey

Producing formation Depth to top Bottom Total Depth of Well 3809 Feet

Show depth and thickness of all water, oil and gas formations.

OIL, GAS OR WATER RECORDS

CASING RECORD

FORMATION	CONTENT	FROM	TO	SIZE	PUT IN	PULLED OUT
				8-5/8"	206'	none
				5 1/2"	3807'	1013'

Describe in detail the manner in which the well was plugged, indicating where the mud fluid was placed and the method or methods used in introducing it into the hole. If cement or other plugs were used, state the character of same and depth placed, from feet to feet for each plug set.

Checked hole to 3809', ran sand to 3800' and ran 5 sacks of cement.
Shot pipe at 3008', 2516', 2006', 1510', 1206', 1004'. Got loose and pulled 34 joints. Pumped 5 sacks hulls, 35 sacks mud and 150 sacks of cement.

PLUGGING COMPLETE.

RECEIVED
STATE CORPORATION COMMISSION
MAR 14 1968
CONSERVATION DIVISION
Wichita, Kansas

(If additional description is necessary, use BACK of this sheet)

Name of Plugging Contractor KNIGHT CASING PULLING COMPANY, INC.

Address CHASE, KANSAS

STATE OF KANSAS, COUNTY OF RICE, ss.

Noel J. Knight (employee of owner) or (owner or operator) of the above-described well, being first duly sworn on oath, says: That I have knowledge of the facts, statements, and matters herein contained and the log of the above-described well as filed and that the same are true and correct. So help me God.

(Signature) Noel J. Knight

Chase, Kansas (Address)

SUBSCRIBED AND SWORN to before me this 13th day of March, 19 68

My commission expires February 15, 1971

Margaret Melcher Notary Public.

Owner - F. O. Miller et al.
Contractor - Virginia Brick Co. Inc.
Commenced - February 22, 1953
Completed - March 6, 1953
Elevation - 2252 ft.
Total Depth - 3812

3 1/8" net at 206 ft.
5" net at 2109 ft.

DESCRIPTION	DEPTH
Sand-shale	0-206
Shale	206-655
Shale-sand	655-2015
Shale-schale	2015-2220
Shale-lime	2220-2350
Shale	2350-2770
Lime	2770-2815
Lime-shale	2815-2870
Lime	2870-2890
Lime-shale	2890-2945
Green lime	2945-2935
Lime-shale	2935-3120
Shale lime	3120-3240
Lime-shale	3240-3300
Lime	3300-3812

- WITS:

Notary TD

S. A. Murphy
S. A. Murphy

Subscribed and sworn to before me, a Notary Public, this
10th day of March, 1953.

Musie Hartman
Musie Hartman
Notary Public

My commission expires: Feb. 5, 1957.

RECEIVED
STATE CORPORATION COMMISSION
MAR 13 1968
CONSERVATION DIVISION
Wichita, Kansas