

STATE OF KANSAS
STATE CORPORATION COMMISSION

Give All Information Completely
Make Required Affidavit
Mail or Deliver Report to:
Conservation Division
State Corporation Commission
800 Bittling Building
Wichita, Kansas

WELL PLUGGING RECORD

Rooks

County. Sec. 35 Twp. 9 Rge. 20 (X) (W)

Location as "NE/CNW/SW" or footage from lines SE 1/4 NW 1/4

Lease Owner I. O. Miller

Lease Name Pywell A Well No. 3A

Office Address P. O. Box 74, Ellis, Kansas

Character of Well (completed as Oil, Gas or Dry Hole) Dry Hole

Date well completed Oct. 1, 1954

Application for plugging filed Oct. 1, 1954

Application for plugging approved Oct. 1, 1954


Plugging commenced Oct. 1, 1954

Plugging completed Oct. 1, 1954

Reason for abandonment of well or producing formation Dry Hole

If a producing well is abandoned, date of last production _____ 19____

Was permission obtained from the Conservation Division or its agents before plugging was commenced? Yes

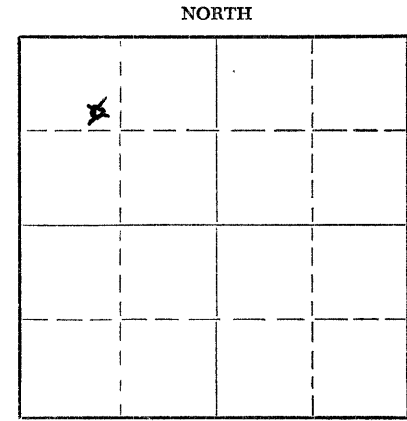

Locate well correctly on above Section Plat

Name of Conservation Agent who supervised plugging of this well Eldon Petty

Producing formation None Depth to top _____ Bottom _____ Total Depth of Well 3872 Feet

Show depth and thickness of all water, oil and gas formations.

OIL, GAS OR WATER RECORDS

CASING RECORD

FORMATION	CONTENT	FROM	TO	SIZE	PUT IN	PULLED OUT

Describe in detail the manner in which the well was plugged, indicating where the mud fluid was placed and the method or methods used in introducing it into the hole. If cement or other plugs were used, state the character of same and depth placed, from _____ feet to _____ feet for each plug set.

Hole filled to 210' from top with heavy mud and bottom plug set. One-half sack of hulls put on top of plug, followed by 15 sacks of cement. Hole filled with heavy mud up to 40' from top and set top plug. One-half sack of hulls placed above top plug, followed by 10 sacks of cement.

RECEIVED
OCT 4 1954
10-4-54
CONSERVATION DIVISION
Wichita, Kansas

(If additional description is necessary, use BACK of this sheet)

Name of Plugging Contractor Virginia Drilling Company

Address 701 Brown Building, Wichita, Kansas

STATE OF Kansas, COUNTY OF Rooks, ss.

_____, (employee of owner) or (owner or operator) of the above-described well, being first duly sworn on oath, says: That I have knowledge of the facts, statements, and matters herein contained and the log of the above-described well as filed and that the same are true and correct. So help me God.

(Signature) Paul W. Miller, Supt
P.O. Box 236 Palco, Kans.
(Address)

SUBSCRIBED AND SWORN to before me this 2nd day of October, 1954

Eva M. Manion
Notary Public.

My commission expires July 27, 1957

PLUGGING
FILE SEC 35 Twp 9 Rge 20
BOOK PAGE 68 LINE 22

15-163-02528-00-00

Pywell A # 3 - SE NW NW/4 Section 35-9-20 Hook County, Kansas
Company - L. O. Miller
Contractor - Virginia Drilg. Co Inc.
Commenced - September 20, 1954
Completed - October 1, 1954
Elevation - 2259 DF
Rotary total depth - 3872

Dry Hole

8 5/8" surface casing - 224 ft.

FORMATION	DEPTH
Shale	0- 30
Sandy shale	30- 90
Shale	90- 750
Shale-sand	750-1450
Shale-shells	1450-1550
Shale	1550-1710
Anhydrite	1710-1760
Shale-shells	1760-2280
Lime-shale	2280-2560
Lime	2560-2720
Lime-shale	2720-3510
Lime	3510-3745
Lime-red shale	3745-3814
Shale-conglomerate	3814-3848
Lime-cherty	3848-3872 T.D.

HOLES:

- 3286 - Howard
- 3316 - Topeka
- 3486 - Heebner
- 3508 - Toronto
- 3524 - Kansas City
- 3747 - Base K C
- 3794 - Conglomerate

M. Hawkins
M. Hawkins

Subscribed and sworn to before me, a Notary Public,
this 6th day of October, 1954.

Arney M. Underwood
Notary Public

My commission expires: March 15, 1958.

PLUGGING
SEE SEC 35-9-20W
PAGE 68 LINE 22

PAUL W. MILLER
P. O. BOX 236
PALCO, KANSAS
Oct. 1, 1954

State Corporation Commission
Conservation Division
Bitting Building
Wichita, Kansas

Lease Owner: I. O. Miller
Lease: Pywell A
Pool: Northampton
Well number: 3 A
Description: SE $\frac{1}{4}$ NW $\frac{1}{4}$ NW $\frac{1}{4}$
Sec. 35-9-20 W
Rooks Co., Kan.

Gentlemen:

The following is a log of the above captioned dry hole:

Elevation 2262 K.B.

Heebner	3486	-1225	
Toronto	3508	-1246	
Lansing KC	3524	*1262	
Base KC	3747	-1485	
Cong.	3794	-1532	
T.D.	3872	*1610	in Conglomerate

This log is attached to Well Plugging Application Form.

Yours truly,

I. O. Miller

By I. O. Miller Sup't.

RECEIVED
STATE CORPORATION COMMISSION
OCT 1 1954
CONSERVATION DIVISION
Wichita, Kansas

PLUGGING
WELL SEC 35 T 9 R 20 W
BOOK PAGE 68 LINE 22