


STATE OF KANSAS  
STATE CORPORATION COMMISSION

Give All Information Completely  
Make Required Affidavit  
Mail or Deliver Report to:  
Conservation Division  
State Corporation Commission  
211 No. Broadway  
Wichita, Kansas

WELL PLUGGING RECORD

Rooks County, Sec. 35 Twp. 9 Rge. 20W (W)

Location as "NE/CNW/SW" or footage from lines NE SW NE  
Lease Owner I. O. Miller  
Lease Name Pywell "B" Well No. 6  
Office Address 619 Brown Bldg., Wichita, Kansas  
Character of Well (completed as Oil, Gas or Dry Hole) Dry Hole  
Date well completed November 12, 1956  
Application for plugging filed November 12, 1956  
Application for plugging approved November 12, 1956  
Plugging commenced November 12, 1956  
Plugging completed November 13, 1956  
Reason for abandonment of well or producing formation Dry Hole

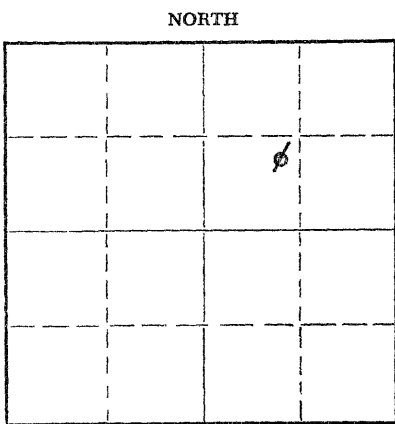

Locate well correctly on above  
Section Plat

If a producing well is abandoned, date of last production None 19  
Was permission obtained from the Conservation Division or its agents before plugging was commenced? Yes

Name of Conservation Agent who supervised plugging of this well Eldon Petty  
Producing formation \_\_\_\_\_ Depth to top \_\_\_\_\_ Bottom \_\_\_\_\_ Total Depth of Well 3865 Feet  
Show depth and thickness of all water, oil and gas formations.

OIL, GAS OR WATER RECORDS

CASING RECORD

FORMATION	CONTENT	FROM	TO	SIZE	PUT IN	PULLED OUT
				8-5/8"	215'	None

Describe in detail the manner in which the well was plugged, indicating where the mud fluid was placed and the method or methods used in introducing it into the hole. If cement or other plugs were used, state the character of same and depth placed, from \_\_\_\_\_ feet to \_\_\_\_\_ feet for each plug set.

Set 215 feet of 8-5/8" surface pipe circulated with cement. Circulated hole with heavy mud, set cementing plug at 200 feet. 1/2 sack of hulls and 15 sacks of cement. Mudded hole to 40 feet, set cementing plug, 1/2 sacks hulls and 10 sacks of cement to bottom of cellar.

(If additional description is necessary, use BACK of this sheet)

Name of Plugging Contractor Virginia Drilling Company, Inc.,  
Address 701 Brown Bldg., Wichita, Kansas

STATE OF KANSAS, COUNTY OF SEDGWICK, ss.  
F. G. Treutle (employee of owner) or (owner or operator)

well, being first duly sworn on oath, says: That I have knowledge of the facts, statements, and matters herein contained and the log of the above-described well as filed and that the same are true and correct. So help me God.

(Signature) *F. G. Treutle*  
619 Brown Bldg., Wichita, Kansas (Address)

SUBSCRIBED AND SWORN TO before me this 17th day of December, 1956

My commission expires January 31, 1957  
Seward S. Greider Notary Public.

RECEIVED  
12-17-56  
PLUGGING  
CONSERVATION DIVISION  
FILE NO. 35 T. 9 W. 20 W. 2  
BOOK PAGE 117 L.I.E. 2

Pywell B #6 NE SW NE Section 35-9-20, Rooks County, Kansas  
 Company: I. O. Miller  
 Contractor: Virginia Drilling Co., Inc.  
 Commenced: November 2, 1956  
 Completed: November 12, 1956  
 Elevation: 2251 RB  
 Total Depth: 3865

FORMATION	DEPTH	
Surface clay-sand	0-40	Set 8-5/8" csg @ 215 ft.
Clay-sand	40-100	
Clay	100-300	
Clay- <del>sand</del> shale	300-550	
Shale-shells	550-630	
Sand-shale	630-885	
Shale-shells	885-1150	
Shale-sand	1150-1350	
Shale	1350-1495	
Clay-redbed-shale	1495-1695	
Anhydrite	1695-1735	
Shale-redbed-shells	1735-1900	TOPS:
Shale-shells	1900-2120	3468 - Heebner
Shale-lime-shells	2120-2250	3488 - Toronto
Shale-lime	2250-3395	3507 - Lansing KC
Lime	3395-3460	3722 - Base KC
Shale-lime	3460-3525	3772 - Conglomerate
Lime	3525-3790	No Arbuckle
Conglomerate	3790-3824	
Chert	3824-3830	
Chert-lime	3830-3860	
Lime	3860-3865 TD	

*S. A. Murphy*  
 S. A. Murphy

Subscribed and sworn to before me, a Notary Public, this 21<sup>st</sup> day of November, 1956.

*Murlee Hawkins*  
 Notary Public

My commission expires: February 5, 1957.

RECEIVED  
 STATE CORPORATION  
 CONSERVATION  
 DIVISION

PLUGGING  
 FILE NO. 35T 9 R 20W  
 BOOK PAGE 117 LINE 2