


STATE OF KANSAS
STATE CORPORATION COMMISSION

Give All Information Completely
Make Required Affidavit
Mail or Deliber Report to:
Conservation Division
State Corporation Commission
212 North Market, Insurance Bldg.
Wichita, Kansas

WELL PLUGGING RECORD

Rooks County. Sec. 31 Twp. 9 Rge. 18 (E) W (W)
Location as "NE/CNW/SW" or footage from lines NW/4 NE/4 SW/4
Lease Owner CLARK T. SNIDER (Formerly Grant Oil Co's)
Lease Name Baumgartner " B " Well No. 1
Office Address 526 Union Center, Wichita 2, Kansas
Character of Well (completed as Oil, Gas or Dry Hole) Oil
Date well completed Nov. 10, 19 58
Application for plugging filed October 17 19 63
Application for plugging approved 19
Plugging commenced 10-21-63 19
Plugging completed 10-24-63 19
Reason for abandonment of well or producing formation Depleted

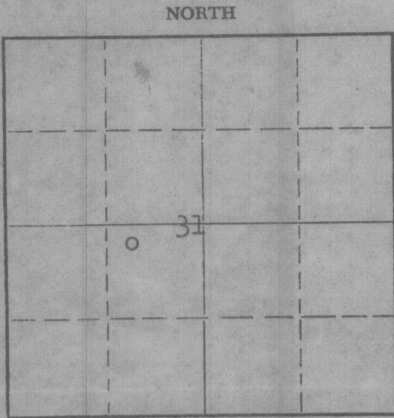

Locate well correctly on above
Section Plat

If a producing well is abandoned, date of last production August 19 62
Was permission obtained from the Conservation Division or its agents before plugging was commenced? Yes

Name of Conservation Agent who supervised plugging of this well Eldon Petty
Producing formation Simpson Depth to top 3725 Bottom 3729 Total Depth of Well 3730 Feet
Show depth and thickness of all water, oil and gas formations.

OIL, GAS OR WATER RECORDS

CASING RECORD

FORMATION	CONTENT	FROM	TO	SIZE	PUT IN	PULLED OUT
				8 5/8	210'	Left in
				5 1/2	3725'	

Describe in detail the manner in which the well was plugged, indicating where the mud fluid was placed and the method or methods used in introducing it into the hole. If cement or other plugs were used, state the character of same and depth placed, from 3730 feet to 3620 feet for each plug set.

A bottom hole cement plug from 3730 to 3620' was dumped with bailer by Hammonds Well Service, Plainville, Kansas, on August 5, 1963.

Pulled 75 joints, pulled 5 joints, mixed and pumped 12 sacks jel at 510'. Pulled 10 joints. Circulated 10 sacks jel and spotted 40 sacks cement at 300'. Pulled 10 joints.

Mudded hole to 35' and sat 5' rock bridge, mixed and dumped 10 sacks cement to base of cellar.

RECEIVED
STATE CORPORATION COMMISSION
10/28/63
OCT 28 1963

CONSERVATION DIVISION
Wichita, Kansas

(If additional description is necessary, use BACK of this sheet)

Name of Plugging Contractor Southwest Casing Pulling Company
Address Box 364 Great Bend, Kansas

STATE OF Kansas, COUNTY OF Barton, ss.
Southwest Casing Pulling Co., Inc. (employee of owner) or (owner or operator) of the above-described

well, being first duly sworn on oath, says: That I have knowledge of the facts, statements, and matters herein contained and the log of the above-described well as filed and that the same are true and correct. So help me God.

(Signature) W. C. Spencer Sec.
Box 364, Great Bend, Kansas
(Address)

SUBSCRIBED AND SWORN TO before me this 25 day of October, 1963

My commission expires 24 October 1964 Sidney D. Miller Notary Public.



15-163-00776-00-00

DRILLERS' LOG

Baumgartner "B" No. 1
Loc: NW NE SW
Sec: 31-9S-18W
Rocks County, Kansas
Company: Grant Oil Co., et al
Contractor: Honaker-Davis Drlg. Co.

Comm: 10-20-58
Comp: 10-30-58
Rotary Total Depth: 3730'
Casing: 8-5/8" at 204'
5-1/2" at 3725'

0	95	Sand & Shale
95	550	Shale
550	1050	Shale & Shells
1050	1290	Sand
1290	1620	Shale & Red Bed
1620	1650	Anhydrite
1650	1950	Shale & Shells
1950	2440	Lime & Shale
2440	2545	Lime
2545	3410	Lime & Shale
3410	3455	Lime
3455	3520	Lime & Shale
3520	3610	Lime
3610	3690	Lime, Shale, Chert
3690	3705	Lime & Chert
3705	3730	Cored Hole
3730		Total Rotary Depth

8-5/8" casing cemented at 204' with 175 sacks cement and 3% calcium chloride.

RECEIVED
STATE CORPORATION COMMISSION
11/26/63
NOV 26 1963

CONSERVATION DIVISION
Wichita, Kansas

5-1/2" casing cemented at 3725' with 75 sacks cement.

I certify that this is a true and correct copy of the above log to the best of my knowledge.

H. S. Forbes
H. S. Forbes

Subscribed and sworn to before me this 3rd day of November, 1958.

Kenneth G. Fischer
Kenneth G. Fischer, Notary Public

My commission expires: 6-25-59