

AFFIDAVIT AND COMPLETION FORM

ACO-1

This form must be filed in triplicate with the Kansas Corporation Commission, 200 Colorado Derby Building, Wichita, Kansas 67202, within five days after the completion of the well, regardless of how the well was completed. Circle one: Oil, gas, dry, SWD, OWWO, injection. Please type. Complete ALL sections. Applications must be filed for dual completion, commingling, salt water disposal and injection. Attach wireline logs (i.e. electrical log, sonic log, gamma ray neutron log, etc.) KCC#-(316) 263-3238.


OPERATOR Wamego Oil, Inc. API NO. 15-163-21,528-00-00  
 ADDRESS 200 Research Drive, Suite "G" COUNTY Rooks  
Manhattan, Kansas 66502 FIELD Kern West  
 \*\*CONTACT PERSON Harold Sadowski LEASE Lambert  
 PHONE (913) 537-4100

PURCHASER None WELL NO. One  
 ADDRESS N/A WELL LOCATION \_\_\_\_\_  
900 Ft. from North Line and  
990 Ft. from East Line of  
 DRILLING CONTRACTOR Pioneer Drilling the SE 1/4 SEC. 29 TWP. 9S RGE. 20W

ADDRESS 308 West Mill  
Plainville, Kansas 67663

PLUGGING CONTRACTOR Pioneer Drilling Co.  
 ADDRESS 308 West Mill; Plainville, Kansas

TOTAL DEPTH 3920' PBTD \_\_\_\_\_  
 SPUD DATE 1-27-82 DATE COMPLETED 2-2-82  
 ELEV: GR2284 DF2287 KB 2289

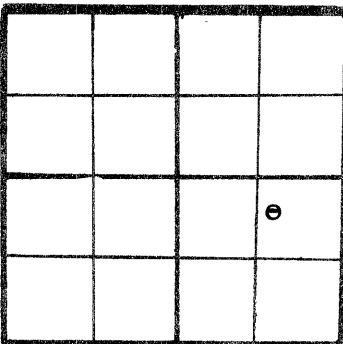

WELL PLAT  
 (Quarter) or (Full) Section - Please indicate.

DRILLED WITH (CABLE) (ROTARY) (AIR) TOOLS  
 Report of all strings set — surface, intermediate, production, etc. (New) (Used) casing.

KCC   
 KGS   
 MISC. \_\_\_\_\_

Purpose of string	Size hole drilled	Size casing set (in O.D.)	Weight lbs/ft.	Setting depth	Type cement	Sacks	Type and percent additives
Surface	12 1/2"	8-5/8"	24#	250'	Common	160	451 lb. cal. 301 lb. gel

LINER RECORD			PERFORATION RECORD		
Top, ft.	Bottom, ft.	Sacks cement	Shots per ft.	Size & type	Depth interval
None	N/A	N/A	None	N/A	N/A
TUBING RECORD					
Size	Setting depth	Packer set at			
None	N/A	N/A			

ACID, FRACTURE, SHOT, CEMENT SQUEEZE RECORD	
Amount and kind of material used	
None	

RECEIVED  
 STATE CORPORATION COMMISSION  
 MAR 12 1982  
 CONSERVATION DIVISION  
 Wichita Kansas

TEST DATE:		PRODUCTION	
Date of first production	Producing method (flowing, pumping, gas lift, etc.)	A.P.I. Gravity	
None	None	N/A	
RATE OF PRODUCTION PER 24 HOURS	Oil	Gas	Water
	N/A	N/A	N/A
Disposition of gas (vented, used on lease or sold)		MCF	CFPB
N/A			
		Producing interval (s)	
		N/A	

\*\* The person who can be reached by phone regarding any questions concerning this information.  
 A witnessed initial test by the Commission is required if the well produces more than 25 BOPD or is located in a Basic Order Pool.

Name of lowest fresh water producing stratum Buried River Bed Depth 100'  
 Estimated height of cement behind pipe N/A

**WELL LOG**

Show all important zones of porosity and contents thereof; cored intervals, and all drill-stem tests, including depth interval tested, cushion used, time tool open, flowing and shut-in pressures, and recoveries.

SHOW GEOLOGICAL MARKERS, LOGS RUN, OR OTHER DESCRIPTIVE INFORMATION.

FORMATION DESCRIPTION, CONTENTS, ETC.	TOP	BOTTOM	NAME	DEPTH
Anhydrite	1776'	+513		+471
Topeka	3331'	-1042		
Heebner	3539'	-1250		
Toronto	3562'	-1273		
Lansing	3580'	-1291		-1517
Conglomert	3866'	-1577		
Reworked Arbuckel	3900'	-1611		
RTD	3920'	-1631		

No Electric Log

No Drill Stem Tests

USE ADDITIONAL SHEETS, IF NECESSARY, TO COMPLETE WELL RECORD.

A F F I D A V I T

STATE OF Kansas, COUNTY OF Geary SS,

Harold G. Sadowski OF LAWFUL AGE, BEING FIRST DULY SWORN UPON HIS OATH, DEPOSES AND SAYS:

THAT HE IS Vice President FOR Wamego Oil, Inc. OPERATOR OF THE Lambert LEASE, AND IS DULY AUTHORIZED TO MAKE THIS AFFIDAVIT FOR AND ON BEHALF OF SAID OPERATOR, THAT WELL NO. One (1) ON SAID LEASE HAS BEEN COMPLETED AS OF THE 2ND DAY OF FEBRUARY 1982, AND THAT ALL INFORMATION ENTERED HEREIN WITH RESPECT TO SAID WELL IS TRUE AND CORRECT.

FURTHER AFFIANT SAITH NOT.

(S) Harold G. Sadowski

SUBSCRIBED AND SWORN TO BEFORE ME THIS 10<sup>th</sup> DAY OF March 1982

VIVIEN L. SADOWSKI  
 STATE NOTARY PUBLIC  
 GEARY COUNTY, KANSAS  
 MY APPOINTMENT EXP. JAN. 22, 1986

Vivien L. Sadowski  
 NOTARY PUBLIC

MY COMMISSION EXPIRES: January 22, 1986