


STATE OF KANSAS
STATE CORPORATION COMMISSION

Give All Information Completely
Make Required Affidavit
Mail or Deliver Report to:
Conservation Division
State Corporation Commission
800 Bitting Building
Wichita, Kansas

WELL PLUGGING RECORD

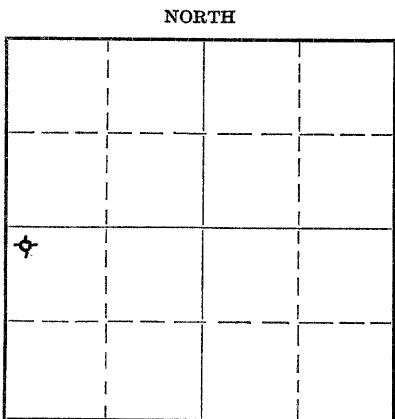

Locate well correctly on above
Section Plat

Rooks County. Sec. 27 Twp. 9 Rge. 20 (W)
Location as "NE/CNW $\frac{1}{4}$ SW $\frac{1}{4}$ " or footage from lines NWc NW SW
Lease Owner D. G. Hansen
Lease Name Marcotte Well No. 1
Office Address Logan, Kansas
Character of Well (completed as Oil, Gas or Dry Hole) Dry Hole
Date well completed 1-2-51 1951
Application for plugging filed 1-2 1951
Application for plugging approved 1-2 1951
Plugging commenced 1-2 1951
Plugging completed 1-2 1951
Reason for abandonment of well or producing formation too low structurally

If a producing well is abandoned, date of last production _____ 19____
Was permission obtained from the Conservation Division or its agents before plugging was commenced? yes

Name of Conservation Agent who supervised plugging of this well Eldon Petty, Hays, Kansas
Producing formation _____ Depth to top _____ Bottom _____ Total Depth of Well _____ Feet
Show depth and thickness of all water, oil and gas formations.

OIL, GAS OR WATER RECORDS

CASING RECORD

Formation	Content	From	To	Size	Put In	Pulled Out
				8 5/8" (25.55#)	182.78'	

Describe in detail the manner in which the well was plugged, indicating where the mud fluid was placed and the method or methods used in introducing it into the hole. If cement or other plugs were used, state the character of same and depth placed, from _____ feet to _____ feet for each plug set.

Filled with drilling mud to 180'. Drove plug to 177'
put in 15 sacks cement then pumped full of mud 35'
from top of hole. Drove plug down to 35' then filled
to top with 10 sacks of cement.

115/51
JAN 25 1951
CONSERVATION DIVISION
WICHITA, KANSAS

(If additional description is necessary, use BACK of this sheet)

Correspondence regarding this well should be addressed to C-G DRILLING Co. Inc.
Address 206 Union National Bank Building, Wichita, Kansas.

STATE OF Kansas, COUNTY OF Sedgwick, ss.
R. A. Cook (employee of owner) or General Contractor

being first duly sworn on oath, says: That I have knowledge of the facts, statements, and matters herein contained and the log of the above-described well as filed and that the same are true and correct. So help me God.

(Signature) R. A. Cook

206 Union National Bank Bldg.
(Address)

SUBSCRIBED AND SWORN to before me this 4th day of January, 1951

Almeda Lowe
Notary Public.

My commission expires August 11, 1954

PLUGGING
FILE SEC 27 9 R 10W
BOOK PAGE 53 LINE 19

CONTRACTOR'S WELL LOG

Operator D. G. Hansen Farm Name Marcotte #1

Location NWc NW SW Sec. 27-9-20W

Pool Name Northampton County Rooks State Kansas

Commencement Date 12-18-50 Completion Date 1-2-51

Log of Well

Elevation 2242 D.F.

All measurements from the top or rotary bushing.

FROM	TO	FORMATION	DEVIATION FROM VERTICAL	REMARKS:
0	180			
180	710	Shale-shells		
710	1000	Shale-sand		
1000	1235	Shale-sand		
1235	1400	Sand		
1400	1540	Shale-sand		
1540	1735	Shale-redbed		
1735	1775	anhydrite		
1775	1995	shale-shells		
1995	2255	Shale-shells		
2255	2455	Shale-lime		
2455	2545	Lime-shale		
2545	2665	Lime-shale		
2665	2840	Lime-shale		
2840	2915	Lime-shale		
2915	3045	Lime-shale		
3045	3205	Lime-shale		
3205	3255	Lime-shale		
3255	3295	Lime		
3295	3365	Lime		
3365	3450	Lime		
3450	3505	Lime		
3505	3555	Lime		
3555	3615	Lime		
3615	3665	Lime		
3665	3705	Lime		
3705	3790	Lime		
3790	3825	Lime-shale		
3825	3857			

CASING LEFT IN HOLE AFTER COMPLETION

Ran 182.78' (6 Jts.) 8 5/8" OD Casing.

STATE OF KANSAS, COUNTY OF SEDGWICK)ss

The undersigned certifies that to the best of his knowledge and belief, the above facts are true and correct.

C-G DRILLING CO. Inc.

By R A Cook, President

Subscribed and sworn to before me this 3rd day of January, 1951,

My Commission Expires:
August 11, 1954

Almeda Lowe
Notary Public

PLUGGING
FILE SEC 27 T 9 R 20W
BOOK PAGE 53 LINE 19