

STATE OF KANSAS  
STATE CORPORATION COMMISSION  
200 Colorado Derby Bldg.  
Wichita, Kansas 67202


RECEIVED  
STATE CORPORATION COMMISSION  
6/29/82  
JUN 29 1982  
CONSERVATION DIVISION  
Wichita, Kansas

Form CP-4  
Rev. 12-15-80

WELL PLUGGING RECORD

Give All Information Completely  
Make Required Affidavit

COUNTY Rooks SEC. 27 TWP. 9 RGE. 20  W  
Location as in quarters or footage from lines:  
1320' West and 330' North of Southeast Corner S2 S2 SE <sup>KCC</sup> <sub>ZAP</sub>

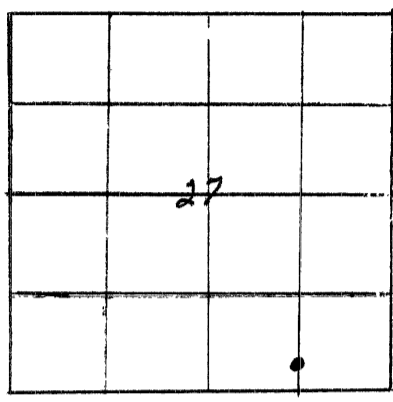

Locate Well  
correctly on above  
Section Platt.

Lease Owner Nadel and Gussman  
Lease Name HINKHOUSE Well No. 10  
Office Address 3200 First National Tower - Tulsa, Okla. 74103  
Character of Well (Completed as Oil, Gas or Dry Hole): Oil  
Date Well Completed 5-4-49  
Application for plugging filed 5-21-82  
Plugging commenced 6-15-82  
Plugging completed 6-15-82  
Reason for abandonment of well or producing formation Depleted

Was permission obtained from the Conservation Division or it's  
Agent's before plugging was commenced? Yes

Name of Conservation Agent who supervised plugging of this well Dennis Hamel  
Producing formation Arbuckle Depth to top 3833 bottom 3836 T.D. 3836  
Show depth and thickness of all water, oil and gas formations.

OIL, GAS OR WATER RECORDS

Casing Record

Formation	Content	From	To	Size	Put in	Pulled Out
Arbuckle	depleted	3833	3836	8-5/8"	132'	None
				5-1/2"	3833'	None

Describe in detail the manner in which the well was plugged, indicating where the mud  
fluid was placed and the method or methods used in introducing it into the hold. If cement  
or other plugs were used, state the character of same and depth placed, from \_\_\_\_\_ feet  
to \_\_\_\_\_ feet for each plug set.

250 sacks of 50/50 Pozmix with 6% Gel and 3% C.C. was pumped down the 5-1/2" and 8-5/8"  
annulus at the same time. Two sacks of hulls were mixed with the first part of the  
cement. Max Pressure 1100#. Had good squeeze pressure which held at end of job.

(If additional description is necessary, use BACK of this sheet)

Name of Plugging Contractor Allied Cementing Company equipment and company supervision.

STATE OF OKLAHOMA COUNTY OF TULSA, ss.  
M. R. Taylor, Manager of Production (employee of owner) or (owner or operator) of the  
above-described well, being first duly sworn on oath, says: That I have knowledge of the  
facts, statements, and matters herein contained and the log of the above-described well as  
filed and that the same are true and correct. So help me God.

(Signature) M R Taylor  
3232 First National Tower - Tulsa, Okla. 7410  
(Address)

SUBSCRIBED AND SWORN TO before me this 25th day of June, 19 82

Mildred Carter  
Mildred Carter Notary Public.

My Commission expires: May 11, 1983

