

STATE OF KANSAS
STATE CORPORATION COMMISSION

WELL PLUGGING RECORD

Give All Information Completely
Make Required Affidavit
Mail or Deliver Report to
Conservation Division
State Corporation Comm.
245 North Water
Wichita, KS 67202

Rooks County. Sec. 32 Twp. 9S Rge. 20 NW
Location as "NE/CNW 1/4 SW 1/4" or footage from lines
430' West line, 1760' North line

Lease Owner Dreiling LTD. OF Colorado

Lease Name Kuehn "B" Well No. 1

Office Address 410 - 17th St., Suite 1140, Denver, Colo. 80202

Character of Well (Completed as Oil, Gas or Dry Hole) _____

Dry Hole

Date Well completed 12-2 19 82

Application for plugging filed 12-7 19 82

Application for plugging approved 12-2 19 82

Plugging commenced 4:30 P.M. 12-2 19 82

Plugging completed 8:30 P.M. 12-2 19 82

Reason for abandonment of well or producing formation _____

Non-productive

If a producing well is abandoned, date of last production _____


None 19 _____

Was permission obtained from the Conservation Division or its agents before plugging was commenced? Yes

Name of Conservation Agent who supervised plugging of this well Carl Goodrow

Producing formation _____ Depth to top _____ Bottom _____ Total Depth of Well 2350'

Show depth and thickness of all water, oil and gas formations.

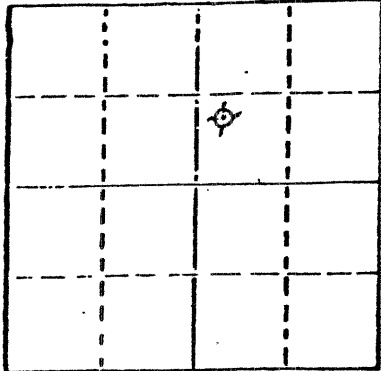

Locate well correctly on above Section Plat

OIL, GAS OR WATER RECORDS

CASING RECORD

FORMATION	CONTENT	FROM	TO	SIZE	PUT IN	PULLED OUT
				8-5/8	253	None

Describe in detail the manner in which the well was plugged, indicating where the mud fluid was placed and the method or methods used in introducing it into the hold. If cement or other plugs were used, state the character of same and depth placed, from _____ feet to _____ feet for each plug set. Hole full of heavy mud. Cemented plugs

through drillpipe as follows:

1st cement plug at 1780' with 20 sacks

2nd cement plug at 950' with 80 sacks

3rd cement plug at 260' with 40 sacks

4th 8-5/8" wood and rubber plug at 40' with 10 sacks

10 sacks in rat hole

10 sacks in mousehole

170 sacks total 50/50 pozmix with 6% gel, 3% cc

(If additional description is necessary, use BACK of this sheet)

Name of Plugging Contractor Halliburton

STATE OF Colorado COUNTY OF Denver, ss.

Leslie Olson (employee of owner) or (owner or operator)

of the above-described well, being first duly sworn on oath, says: That I have knowledge of the facts, statements, and matters herein contained and the log of the above-described well as filed and that the same are true and correct. So help me God.

(Signature) Leslie Olson

410 - 17th St., Suite 1140, Denver, Co. 80202
(Address)

SUBSCRIBED AND SWORN TO before me this 8th day of December, 19 82

Serraine C. Murphy
Notary Public.

My commission expires 9-2-83

STATE CORPORATION COMMISSION
12/13/82
DEC 15 1982
CONSERVATION DIVISION
Wichita, Kansas