


STATE OF KANSAS
STATE CORPORATION COMMISSION
Give All Information Completely
Make Required Affidavit
Mail or Deliver Report to:
Conservation Division
State Corporation Commission
800 Bitting Building
Wichita, Kansas

WELL PLUGGING RECORD

OR
FORMATION PLUGGING RECORD

Strike out upper line when reporting plugging off formations.

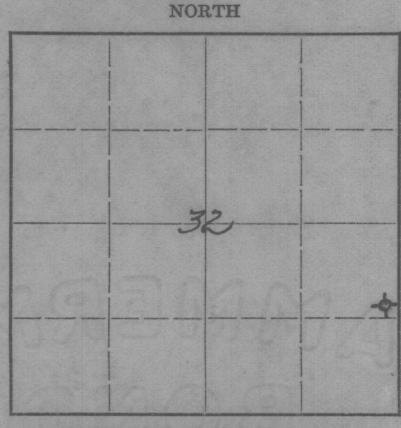

ROOKS County. Sec. 32 Twp. 9 Rge. (E) 20 (W)

Location as "NE 1/4 NW 1/4 SW 1/4" or footage from lines. SE NE SE
Lease Owner Jones, Shelburne & Farmer, Inc.
Lease Name F. O. Miller Well No. 1
Office Address Box 659, Great Bend, Kansas

Character of Well (completed as Oil, Gas or Dry Hole).....
Date well completed 6/20 19 47
Application for plugging filed July 4th 19 47
Application for plugging approved July 4th 19 47
Plugging commenced July 5th 19 47
Plugging completed July 5th 19 47
Reason for abandonment of well or producing formation Dry

If a producing well is abandoned, date of last production None 19

Was permission obtained from the Conservation Division or its agents before plugging was commenced? Yes

Name of Conservation Agent who supervised plugging of this well Nr. Kerr, Great Bend
Producing formation None Depth to top Bottom Total Depth of Well Feet

Show depth and thickness of all water, oil and gas formations.


OIL, GAS OR WATER RECORDS

CASING RECORD

Formation	Content	From	To	Size	Put In	Pulled Out
Sand	Water	35	60	13 3/8"	283'	None

Describe in detail the manner in which the well was plugged, indicating where the mud fluid was placed and the method or methods used in introducing it into the hold. If cement or other plugs were used, state the character of same and depth placed, from feet to feet for each plug set.

Heavy mud was circulated from top to bottom. A bridge consisting of 20 sacks of cement in lower end of surface pipe from 225 to 283. Another cement bridge consisting of 20 sacks of cement was placed in top of surface pipe from 0 to 60'.

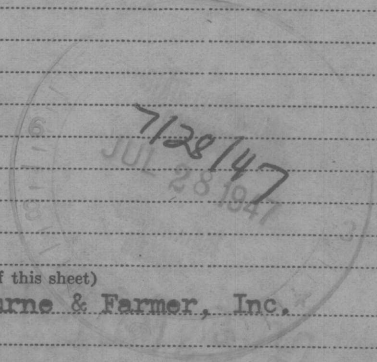

(If additional description is necessary, use BACK of this sheet)

Correspondence regarding this well should be addressed to Jones, Shelburne & Farmer, Inc.
Address Box 659, Great Bend, Kansas

STATE OF Oklahoma, COUNTY OF Oklahoma, SS.
John O. Farmer (employee of owner) or (owner or operator) of the above-described well,
being first duly sworn on oath, says: That I have knowledge of the facts, statements, and matters herein contained and the log of the above-described well as filed and that the same are true and correct. So help me God.

(Signature) John O. Farmer
Box 659, Great Bend, Kansas (Address)

SUBSCRIBED AND SWORN to before me this 26th day of July, 19 47
H. O. Muller Notary Public.

My commission expires Mar 8 1951


PLUGGING
FILE SEC 32 T 9 R 204
BOOK PAGE 119 LINE 12

DRILLERS LOG

Jones, Shelburne & Farmer, Inc.
 #1 Miller
 SE NE SE Section 32-9S-20W.
 Rocks County, Kansas.

Date Commenced: 6/20/47
 Date Completed: 7/4/47

Depth	Formation
0 35	Surface Clay
35 60	Sand
60 283	Shale
283 825	Shale & Sand
825 890	Shale & Shells
890 985	Sand
985 1200	Shale & Shells
1200 1525	Sand & Shale
1525 1610	Red Bed
1610 1745	Red Rock
1745 1795	Anhydrite
1795 2515	Shale & Lime
2515 2565	Lime
2565 2645	Lime & Shale
2645 2735	Lime
2735 3526	Lime & Shale
3526 3628	Lime
3628 3635	Soft Lime
3635 3723	Lime
3723 3784	Lime & Shale
3784 3822	Conglomerate
3822 3865	Lime
3865	TOTAL DEPTH

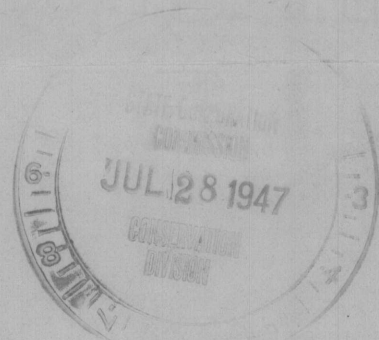

PLUGGING
 FILE SEC 32 T 9 R 20W
 BOOK PAGE 119 LINE 12