


STATE OF KANSAS  
STATE CORPORATION COMMISSION

Form CP-4

Give All Information Completely  
Make Required Affidavit  
Mail or Deliver Report to:  
Conservation Division  
State Corporation Commission  
212 No. Market  
Wichita, Kansas

WELL PLUGGING RECORD

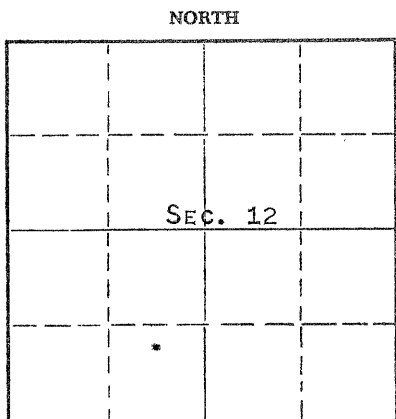

Locate well correctly on above  
Section Plat

GRAHAM County. Sec. 12 Twp. 9S Rge. 21 (R) (W)  
Location as "NE/CNW%SW%" or footage from lines N/2 SE SW  
Lease Owner PETROLEUM, INC.,  
Lease Name BALTHAZOR "C" Well No. 1  
Office Address R.R. #2, GREAT BEND, KANSAS  
Character of Well (completed as Oil, Gas or Dry Hole) DRY HOLE  
Date well completed Nov. 3 19 66  
Application for plugging filed Nov. 3 19 66  
Application for plugging approved Nov. 3 19 66  
Plugging commenced Nov. 3 19 66  
Plugging completed Nov. 3 19 66  
Reason for abandonment of well or producing formation NO PRODUCIBLE ZONE

If a producing well is abandoned, date of last production NONE 19  
Was permission obtained from the Conservation Division or its agents before plugging was commenced? YES

Name of Conservation Agent who supervised plugging of this well W. L. NICHOLS  
Producing formation \_\_\_\_\_ Depth to top \_\_\_\_\_ Bottom \_\_\_\_\_ Total Depth of Well 3721' Feet  
Show depth and thickness of all water, oil and gas formations.

OIL, GAS OR WATER RECORDS

CASING RECORD

FORMATION	CONTENT	FROM	TO	SIZE	PUT IN	PULLED OUT
				8-5/8"	213	NONE

Describe in detail the manner in which the well was plugged, indicating where the mud fluid was placed and the method or methods used in introducing it into the hole. If cement or other plugs were used, state the character of same and depth placed, from \_\_\_\_\_ feet to \_\_\_\_\_ feet for each plug set.

MUD TO 540', FOLLOWED BY WOODEN PLUG, PLACED 25 SACKS CEMENT ON TOP OF PLUG.  
MUD TO 210', FOLLOWED BY WOODEN PLUG, PLACED 20 SACKS CEMENT ON TOP OF PLUG.  
MUD TO 40', BRIDGE PLACED 8 SACKS CEMENT TO BASE OF WELL CELLAR.

(If additional description is necessary, use BACK of this sheet)

Name of Plugging Contractor GARVEY DRILLING CO.  
Address R.R. #2, GREAT BEND, KANSAS

STATE OF KANSAS, COUNTY OF BARTON, ss.  
MONTE CHADD (employee of owner) or (XXXXXX XXXXXX) of the above-described well, being first duly sworn on oath, says: That I have knowledge of the facts, statements, and matters herein contained and the log of the above-described well as filed and that the same are true and correct. So help me God.  
MONTE CHADD, Dist. PROD. Supt.  
(Signature)

SUBSCRIBED AND SWORN TO before me this 15 day of NOVEMBER, 19 66

My commission expires MAY 28, 1969  
Richard A. Dangler Notary Public.

15-065-30205-00-00

# WELL LOG

COMPANY Petroleum, Incorporated

SEC. 12 T. 9S R. 21W

FARM Balthazor

NO. C-1

LOC. N/2 SE SW


TOTAL DEPTH 3721'

COUNTY Graham

COMM. 10-25-66

COMP. 11-2-66

CONTRACTOR Garvey Drilling Company

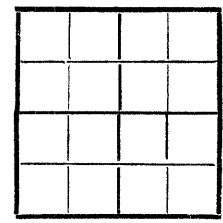

CASING 8 5/8" @ 213' w/175 sx

ELEVATION 2144' DF

PRODUCTION D & A

FIGURES INDICATE BOTTOM OF FORMATIONS

- 65' Surface and Shale
- 75' Sand and Shale
- 214' Sand, Shale, and Shells
- 630' Shale
- 1140' Shale, Sand, and Shells
- 1380' Sand and Shale
- 1656' Shale and Red Bed
- 1696' Anhydrite
- 1875' Salt and Shale
- 2300' Shale and Shells with Lime Streaks
- 2535' Shale with Lime
- 2930' Lime and Shale
- 3195' Shale and Lime
- 3395' Lime with Shale
- 3675' Lime
- 3681' Lime - Arbuckle
- 3721' Lime
- 3721' RTD

RECEIVED  
 STATE CORPORATION COMMISSION  
 NOV 16 1966  
 CONSERVATION DIVISION  
 Wichita, Kansas

State of Kansas  
 County of Barton } ss

I, Sam N. Stephens of Garvey Drilling Company

upon oath state the above and foregoing is a true and correct copy of the log of the Balthazor C-1 well.

*Sam N. Stephens*

Subscribed and sworn to before me this 11th day of November 19 66

My Commission Expires: November 5, 1969

*Richard Doy*  
 NOTARY PUBLIC