


STATE OF KANSAS  
STATE CORPORATION COMMISSION  
200 Colorado Derby Bldg.  
Wichita, Kansas 67202

Form CP-4  
Rev. 12-15-80

WELL PLUGGING RECORD

Give All Information Completely  
Make Required Affidavit

COUNTY Graham SEC. 12 TWP. 9S RGE. 21W ~~EXW~~  
Location as in quarters or footage from lines:  
NE NE SW

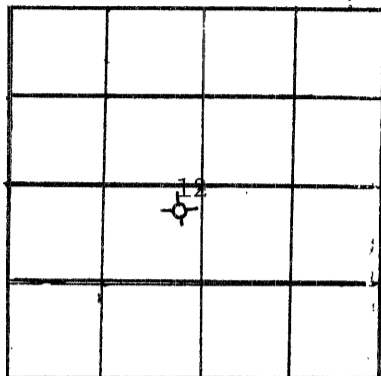

Locate Well  
correctly on above  
Section Platt.

Lease Owner John O. Farmer, Inc.  
Lease Name Balthazor Well No. #1  
Office Address P.O. Box 352, Russell, KS 67665  
Character of Well (Completed as Oil, Gas or Dry Hole): Dry Hole  
Date Well Completed September 7, 1983  
Application for plugging filed Yes  
Plugging commenced \_\_\_\_\_  
Plugging completed 6:30 A.M., September 7, 1983  
Reason for abandonment of well or producing formation \_\_\_\_\_

Was permission obtained from the Conservation Division or it's  
Agent's before plugging was commenced? Yes

Name of Conservation Agent who supervised plugging of this well Carl Goodrow  
Producing formation \_\_\_\_\_ Depth to top \_\_\_\_\_ bottom T.D. 3690'

Show depth and thickness of all water, oil and gas formations.

OIL, GAS OR WATER RECORDS Casing Record

Formation	Content	From	To	Size	Put in	Pulled Out
				8-5/8"	201'	

Describe in detail the manner in which the well was plugged, indicating where the mud  
fluid was placed and the method or methods used in introducing it into the hold. If cement  
or other plugs were used, state the character of same and depth placed, from \_\_\_\_\_ feet  
to \_\_\_\_\_ feet for each plug set.

- Plug #1 @ 1630' w/20 sks. cement
- Plug #2 @ 850' w/100 sks. cement
- Plug #3 @ 225' w/40 sks. cement
- Plug #4 @ 40' w/10 sks. cement

10 sks. cement in rathole

RECEIVED  
STATE CORPORATION COMMISSION  
9/19/83  
SEP 19 1983  
CONSERVATION DIVISION  
Wichita, Kansas

(If additional description is necessary, use BACK of this sheet)

Name of Plugging Contractor John O. Farmer, Inc.  
P.O. Box 352, Russell, KS 67665

STATE OF Kansas COUNTY OF Russell, ss.

John O. Farmer III (~~employee of owner~~) (owner or operator) of the  
above-described well, being first duly sworn on oath, says: That I have knowledge of the  
facts, statements, and matters herein contained and the log of the above-described well as  
filed and that the same are true and correct. So help me God.

(Signature) John O. Farmer III  
P.O. Box 352, Russell, KS 67665  
(Address)



SUBSCRIBED AND SWORN TO before me this 16th day of September, 19 83

Margaret A. Schulte  
Margaret A. Schulte Notary Public.