

CARD MUST BE TYPED

State of Kansas

CARD MUST BE SIGNED

NOTICE OF INTENTION TO DRILL

(see rules on reverse side)

Starting Date 06-18-86
month day year

API Number 15— 125-28,357-00-00

OPERATOR: License # 6382
Name E. S. ENERGY SOURCES, INC.
Address 2707 Mo. Blvd.
City/State/Zip JEFFERSON CITY, MO. 65101
Contact Person R. L. WOODY
Phone 314.893.3443

..... X East
..... SE SE SE Sec. 1... Twp. 35. S, Rg. 15.... West
..... 330' Ft. from South Line of Section
..... 330' Ft. from East Line of Section

(Note: Locate well on Section Plat on reverse side)

CONTRACTOR: License # 5831
Name Mokat, D. ~~.....~~
City/State Caney, Kansas

Nearest lease or unit boundary line 330' feet
County MONTGOMERY

Lease Name FIELDS Well # 3
Ground surface elevation 825' feet MSL

Well Drilled For: Well Class: Type Equipment:
X Oil ___ SWD X Infield ___ Mud Rotary
___ Gas ___ Inj ___ Pool Ext. X Air Rotary
___ OWWO ___ Expl ___ Wildcat X Cable

Domestic well within 330 feet: ___ yes X no
Municipal well within one mile: ___ yes X no

Surface pipe by Alternate: 1 ___ 2 X

If OWWO: old well info as follows:

Operator
Well Name
Comp Date Old Total Depth

Depth to bottom of fresh water 807'4"

Depth to bottom of usable water 175'

Surface pipe planned to be set 40'

Projected Total Depth 1200' feet

Formation BARTLESVILLE

I certify that well will comply with K.S.A. 55-101, et seq., plus eventually plugging hole to KCC specifications.

Date 6-09-86 Signature of Operator or Agent *R.L. Woody* Title VP

RCH/KS/H

For KCC Use:

Conductor Pipe Required feet; Minimum Surface Pipe Required 20 feet per Alt.


This Authorization Expires 12-12-86 Approved By 6-12-86 *R*

Must be filed with the K.C.C. five (5) days prior to commencing well
This card void if drilling not started within six (6) months of date received by K.C.C.

Important procedures to follow:

1. Notify District office before setting surface casing.
2. Set surface casing by circulating cement to the top.
3. File completion forms ACO-1 with K.C.C. within 90 days of well completion, following instructions on ACO-1, side 1, and including copies of wireline logs.
4. Notify District office 48 hours prior to old well workover or re-entry.
5. Prior to filing Intent, prepare a proposed plugging plan in case well is D & A, then obtain approval of plan when calling district office prior to setting surface pipe.
6. Submit plugging report (CP-4) to K.C.C. after plugging is completed.
7. Obtain an approved injection docket number before disposing of salt water.
8. Notify K.C.C. within 10 days when injection commences or terminates.
9. If an alternate 2 completion, cement in the production pipe from below any usable water to surface within 120 days of spud date.

A Regular Section of Land 1 Mile = 5,280 Ft.

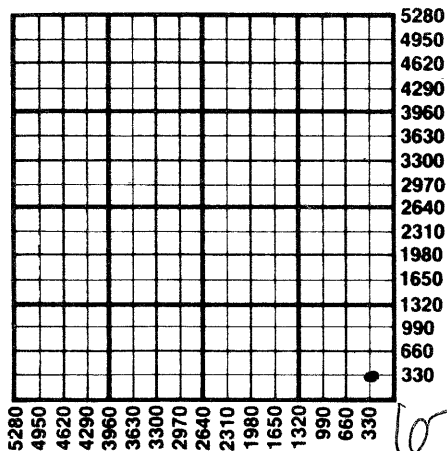

RECEIVED
STATE CORPORATION COMMISSION

JUN 12 1985

CONSERVATION DIVISION
Wichita, Kansas

State Corporation Commission of Kansas
Conservation Division
200 Colorado Derby Building
Wichita, Kansas 67202
(316) 263-3238