

CARD MUST BE TYPED

State of Kansas
NOTICE OF INTENTION TO DRILL
 (see rules on reverse side)

CARD MUST BE SIGNED

Starting Date: 10 - 26 - 1984
 month day year

OPERATOR: License # 6787
 Name Collins Oil Co.
 Address 6740 E. 24th St.
 City/State/Zip Tulsa, Ok 74129
 Contact Person Sam Collins
 Phone (316) 289-4417

CONTRACTOR: License # 6737
 Name Collins Oil Co.
 City/State Tulsa, Ok

Well Drilled For:	Well Class:	Type Equipment:
☒ Oil ☐ Swd	☐ Infield	☐ Mud Rotary
☐ Gas ☐ Inj	☒ Pool Ext.	☐ Air Rotary
☐ OWWO ☐ Expl	☐ Wildcat	☒ Cable

If OWWO: old well info as follows:

Operator
 Well Name
 Comp Date Old Total Depth
 Projected Total Depth 650 feet
 Projected Formation at TD Wayside Sand
 Expected Producing Formations Wayside Sand

I certify that we will comply with K.S.A. 55-101, et seq., plus eventually plugging hole to K.C.C. specifications.

Date 10/20/84
 Signature of Operator or Agent

R. E. Collins

Title Partner

API Number 15-

125-27,348-00-00
~~SE SE~~
~~SW~~ SW Sec 4 Twp 35 S, Rge 15E ☒ East
 (location) ☐ West

..... 330 Ft North from Southeast Corner of Section
 3150 Ft West from Southeast Corner of Section
 (Note: Locate well on Section Plat on reverse side)

Nearest lease or unit boundary line 330 feet.

County Montgomery

Lease Name Bush Well# 3A

Domestic well within 330 feet : ☐ yes ☒ noMunicipal well within one mile : ☐ yes ☒ no

Depth to Bottom of fresh water 80 feet

Lowest usable water formation 80 feet

Depth to Bottom of usable water 80 / 175 feet

Surface pipe by Alternate : 1 ☐ 2 ☒

Surface pipe to be set 100 feet

Conductor pipe if any required X feet

Ground surface elevation 880 feet MSL

This Authorization Expires 4-24-85


Approved By 10-24-84 *R*

mhc/kdhe 10/24/84

Must be filed with the K.C.C. five (5) days prior to commencing well
This card void if drilling not started within six (6) months of date received by K.C.C.

Important procedures to follow :

**A Regular Section of Land
1 Mile = 5,280 Ft.**

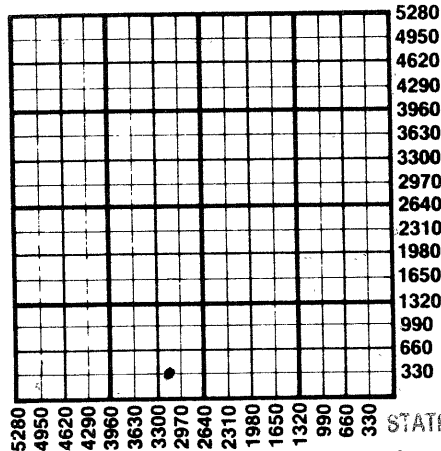

1. Notify District office before setting surface casing.
2. Set surface casing by circulating cement to the top.
3. File completion forms ACO-1 with K.C.C. within 90 days of well completion, following instructions on ACO-1, side 1, and including copies of wireline logs.
4. Notify District office 48 hours prior to old well workover or re-entry.
5. Prior to plugging, prepare a plugging plan, then obtain agreement from the appropriate district office for an approved plugging plan.
6. Submit plugging report (CP-4) to K.C.C. after plugging is completed.
7. Obtain an approved injection docket number before disposing of salt water.
8. Notify K.C.C. within 10 days when injection commences or terminates.
9. If an alternate 2 completion, cement in the production pipe from below any usable water to surface within 120 days of spud date.

RECEIVED
STATE CORPORATION COMMISSION

State Corporation Commission of Kansas
Conservation Division
200 Colorado Derby Building
Wichita, Kansas 67202
(316) 263-3238

CONSERVATION DIVISION
Wichita, Kansas