

CARD MUST BE TYPED

State of Kansas

CARD MUST BE SIGNED

NOTICE OF INTENTION TO DRILL

(see rules on reverse side)

Starting Date 9/20/85
month day year 11:00

API Number 15— 125-28,029-00-00

OPERATOR: License #... 5566.....
Name Martindale Enterprises, Inc.....
Address... 8222 Douglas Avenue #680.....
City/State/Zip Dallas, TX... 75225.....
Contact Person... Bill Martindale.....
Phone 214.361.1680.....

..... East
app SE.NW.SE Sec..5... Twp.35.. S, Rg.15.... ___ West
..... 1495..... Ft. from South Line of Section
..... 1975..... Ft. from East Line of Section

(Note: Locate well on Section Plat on reverse side)

CONTRACTOR: License # ... 9341.....
Name B.R. Walker Drlg.....
City/State Nowata, OK... 74048.....

Nearest lease or unit boundary line 175..... feet
County... Montgomery.....

Lease Name... Harold Walls..... Well #... 5.....
Ground surface elevation na..... feet MSL

Well Drilled For: Well Class: Type Equipment:
 Oil ___ SWD ___ Infield ___ Mud Rotary
___ Gas ___ Inj Pool Ext. Air Rotary
___ OWWO ___ Expl ___ Wildcat ___ Cable

Domestic well within 330 feet: ___ yes no
Municipal well within one mile: ___ yes no
Surface pipe by Alternate: 1 ___ 2 3 ___

If OWWO: old well info as follows:

Operator
Well Name
Comp Date Old Total Depth.....

Depth to bottom of fresh water..... 135.....
Depth to bottom of usable water 175.....
Surface pipe planned to be set 100.....
Projected Total Depth 1500..... feet
Formation... Mississippi.....

I certify that well will comply with K.S.A. 55-101, et seq., plus eventually plugging hole to KCC specifications.

_____ cementing will be done immediately upon setting production casing.

Date 9/20/85.... Signature of Operator or Agent *Awan Arnold* Title... As agent *pet/KOHE*

For KCC Use:

Conductor Pipe Required feet; Minimum Surface Pipe Required feet per Alt. 1 2


This Authorization Expires... 3-20-86 Approved By 9-20-85

Must be filed with the K.C.C. five (5) days prior to commencing well
 This card void if drilling not started within six (6) months of date received by K.C.C.

9-20-85

Important procedures to follow:

**A Regular Section of Land
 1 Mile = 5,280 Ft.**

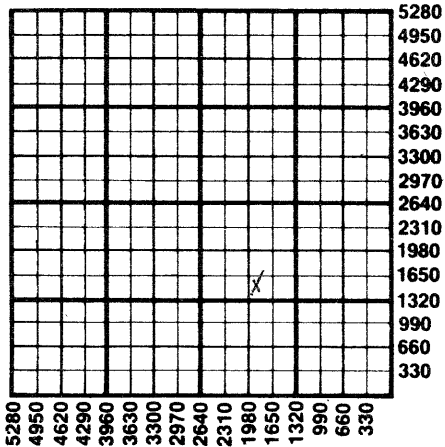

RECEIVED
 STATE CORPORATION COMMISSION

SEP 20 1985

CONSERVATION DIVISION
 Wichita, Kansas

1. Notify District office before setting surface casing.
2. Set surface casing by circulating cement to the top.
3. File completion forms ACO-1 with K.C.C. within 90 days of well completion, following instructions on ACO-1, side 1, and including copies of wireline logs.
4. Notify District office 48 hours prior to old well workover or re-entry.
5. Prior to filing Intent, prepare a proposed plugging plan in case well is D & A, then obtain approval of plan when calling district office prior to setting surface pipe.
6. Submit plugging report (CP-4) to K.C.C. after plugging is completed.
7. Obtain an approved injection docket number before disposing of salt water.
8. Notify K.C.C. within 10 days when injection commences or terminates.
9. If an alternate 2 completion, cement in the production pipe from below any usable water to surface within 120 days of spud date.

State Corporation Commission of Kansas
 Conservation Division
 200 Colorado Derby Building
 Wichita, Kansas 67202
 (316) 263-3238