

CARD MUST BE TYPED

State of Kansas

CARD MUST BE SIGNED

NOTICE OF INTENTION TO DRILL

(see rules on reverse side)

Starting Date 10 month 12 day 1985 year 2:50

API Number 15— 125-28077-00-00

OPERATOR: License # 5566
Name Martindale Enterprises, Inc.
Address 8222 Douglas Ave. #680
City/State/Zip Dallas, TX 75225
Contact Person Bill Martindale
Phone 214.361.1680

..... East
..... NW SE Sec...5. Twp...35. S, Rg....15. West
..... 2.050 Ft. from South Line of Section
..... 2.100 Ft. from East Line of Section

(Note: Locate well on Section Plat on reverse side)

CONTRACTOR: License # 9341
Name B. R. Walker Delg
City/State/Zip Box 707 Nowata, OK 74048

Nearest lease or unit boundary line 590 feet
County Montgomery

Lease Name Harold Walls Well # ... 4
Ground surface elevation na feet MSL

Well Drilled For: Well Class: Type Equipment:
 Oil SWD Infield Mud Rotary
 Gas Inj Pool Ext. Air Rotary
 OWWO Expl Wildcat Cable

Domestic well within 330 feet: _____ yes no
Municipal well within one mile: _____ yes no

Surface pipe by Alternate: 1 _____ 2

If OWWO: old well info as follows:

Operator
Well Name
Comp Date Old Total Depth

Depth to bottom of fresh water 135
Depth to bottom of usable water 175

Surface pipe planned to be set 100

Projected Total Depth 1400 feet

Formation Mississippi

I certify that well will comply with K.S.A. 55-101, et seq., plus eventually plugging hole to KCC specifications.

_____ cementing will be done immediately upon setting production casing.

Date ... 10/11/85. Signature of Operator or Agent Elaine Barlow Title As agent

For KCC Use:

Conductor Pipe Required feet; Minimum Surface Pipe Required feet per Alt. 1 2

This Authorization Expires 4-11-86 Approved By 10-11-85

Must be filed with the K.C.C. five (5) days prior to commencing well
This card void if drilling not started within six (6) months of date received by K.C.C.

Important procedures to follow:


RECEIVED
STATE CORPORATION COMMISSION

Notify District office before setting surface casing.

A Regular Section of Land
1 Mile = 5,280 Ft.

OCT 11 1985

CONSERVATION DIVISION
Wichita, Kansas

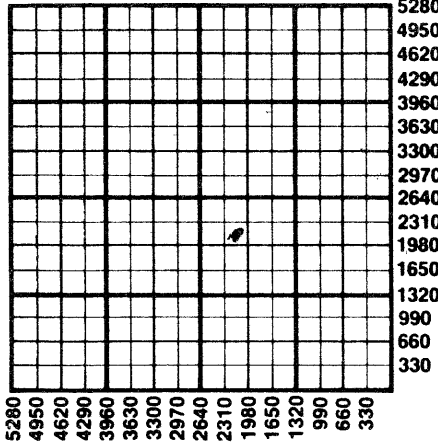

2. Set surface casing by circulating cement to the top.
3. File completion forms ACO-1 with K.C.C. within 90 days of well completion, following instructions on ACO-1, side 1, and including copies of wireline logs.
4. Notify District office 48 hours prior to old well workover or re-entry.
5. Prior to filing Intent, prepare a proposed plugging plan in case well is D & A, then obtain approval of plan when calling district office prior to setting surface pipe.
6. Submit plugging report (CP-4) to K.C.C. after plugging is completed.
7. Obtain an approved injection docket number before disposing of salt water.
8. Notify K.C.C. within 10 days when injection commences or terminates.
9. If an alternate 2 completion, cement in the production pipe from below any usable water to surface within 120 days of spud date.

State Corporation Commission of Kansas
Conservation Division
200 Colorado Derby Building
Wichita, Kansas 67202
(316) 263-3238