

CARD MUST BE TYPED

State of Kansas

CARD MUST BE SIGNED

NOTICE OF INTENTION TO DRILL

(see rules on reverse side)

Starting Date 4 3 86
month day year 2'25

API Number 15- 125-28,319-00-00

OPERATOR: License # 5566
Name Martindale Enterprises, Inc.
Address 8222 Douglas Ave. #680
City/State/Zip Dallas, TX. 75225
Contact Person Bill Martindale
Phone (214) 361-1680

app. SE NW SE Sec. 5 Twp. 35 S, Rg. 15 East
..... 1350 West
..... 1515 Ft. from South Line of Section
..... Ft. from East Line of Section

(Note: Locate well on Section Plat on reverse side)

CONTRACTOR: License # 9341
Name B.R. Walker Drlg.
City/State Box 707 Nowata, OK 74048

Nearest lease or unit boundary line 290 feet
County Montgomery
Lease Name Harold Walls Well # 2

Well Drilled For: Well Class: Type Equipment:
 Oil SWD Infield Mud Rotary
 Gas Inj Pool Ext. Air Rotary
 OWWO Expl Wildcat Cable

Ground surface elevation feet MSL
Domestic well within 330 feet: yes no
Municipal well within one mile: yes no
Depth to bottom of fresh water 135
Depth to bottom of usable water 175

If OWWO: old well info as follows:
Operator
Well Name
Comp Date Old Total Depth

Surface pipe by Alternate: 1 2
Surface pipe planned to be set 20
Conductor pipe required
Projected Total Depth 1500 feet
Formation Mississippi

I certify that well will comply with K.S.A. 55-101, et seq; plus eventually plugging hole to KCC specifications.
Date 4-3-86 Signature of Operator or Agent Wona Eemore Title as agent


For KCC Use:
Conductor Pipe Required feet; Minimum Surface Pipe Required 20 feet per Alt. 4 ②
This Authorization Expires 10-4-86 Approved By 4-3-86 *[Signature]*

Must be filed with the K.C.C. five (5) days prior to commencing well
This card void if drilling not started within six (6) months of date received by K.C.C.

Important procedures to follow:

1. Notify District office before setting surface casing.
2. Set surface casing by circulating cement to the top.
3. File completion forms ACO-1 with K.C.C. within 90 days of well completion, following instructions on ACO-1, side 1, and including copies of wireline logs.
4. Notify District office 48 hours prior to old well workover or re-entry.
5. Prior to filing Intent, prepare a proposed plugging plan in case well is D & A, then obtain approval of plan when calling district office prior to setting surface pipe.
6. Submit plugging report (CP-4) to K.C.C. after plugging is completed.
7. Obtain an approved injection docket number before disposing of salt water.
8. Notify K.C.C. within 10 days when injection commences or terminates.

**A Regular Section of Land
1 Mile = 5,280 Ft.**

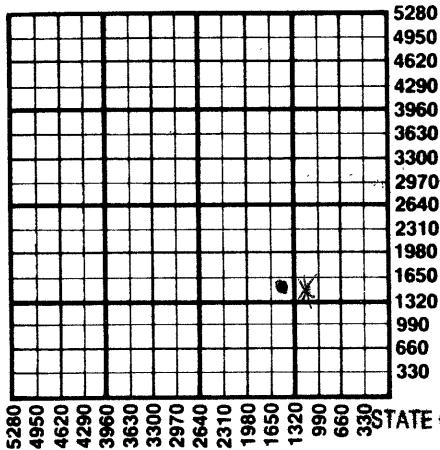

RECEIVED
STATE CORPORATION COMMISSION

APR 3 1986

CONSERVATION DIVISION
Wichita, Kansas

43-86

... alternate 2 completion, cement in the production pipe from below any usable water to surface within 120 days of spud date.

State Corporation Commission of Kansas
Conservation Division
200 Colorado Derby Building
Wichita, Kansas 67202
(316) 263-3238