

CARD MUST BE TYPED

State of Kansas

CARD MUST BE SIGNED

NOTICE OF INTENTION TO DRILL

(see rules on reverse side)

Expected Spud Date..... 1 month 15 day 88 year

API Number 15- 125-28,978-00-00

OPERATOR: License # 03196
Name G. & G Resources Company
Address P. O. Box 807
City/State/Zip Broken Arrow, OK 74013
Contact Person Perry E. Gilstrap
Phone (918) 455-0378

NW SE SW Sec. 5 Twp. 35 S, Rg. 15 East
990 West
3630 Ft. from South Line of Section
Ft. from East Line of Section

(Note: Locate well on Section Plat on reverse side)

CONTRACTOR: License #
Name
City/State

Nearest lease or unit boundary line 330 feet
County Montgomery
Lease Name Sanders Well # 1-A

Well Drilled For: Well Class: Type Equipment:
 Oil Storage Infield Mud Rotary
 Gas Inj Pool Ext. Air Rotary
 OWWO Expl Wildcat Cable

Ground surface elevation 860 feet MSL
Domestic well within 330 feet: yes no
Municipal well within one mile: yes no
Depth to bottom of fresh water.....
Depth to bottom of usable water 175

If OWWO: old well info as follows:

Operator
Well Name
Comp Date..... Old Total Depth.....

Surface pipe by Alternate: 1 2 _____
Surface pipe planned to be set 250'
Conductor pipe required
Projected Total Depth 1500 feet
Formation Mississippi Lime

I certify that well will comply with K.S.A. 55-101, et seq., plus eventually plugging hole to KCC specifications.

Date 1-4-88 Signature of Operator or Agent Perry E. Gilstrap Title President

For KCC Use:

Conductor Pipe Required feet; Minimum Surface Pipe Required feet per Alt. 250
This Authorization Expires 7-7-88 Approved By Perry E. Gilstrap 1-7-88


EFFECTIVE DATE: 1-12-88

Must be filed with the K.C.C. five (5) days prior to commencing well
This card void if drilling not started within six (6) months of date received by K.C.C.

Important procedures to follow:

1. Notify District office before setting surface casing.
2. Set surface casing by circulating cement to the top.
3. File completion forms ACO-1 with K.C.C. within 120 days of well spud date, following instructions on ACO-1, side 1, and including copies of wireline logs.
4. Notify District office 48 hours prior to old well workover or re-entry.
5. Prior to filing Intent, prepare a proposed plugging plan in case well is D & A, then obtain approval of plan when calling district office prior to setting surface pipe.
6. Submit plugging report (CP-4) to K.C.C. after plugging is completed.
7. Obtain an approved injection docket number before disposing of salt water.
8. Notify K.C.C. within 10 days when injection commences or terminates.
9. If an alternate 2 completion, cement in the production pipe from below any usable water to surface within 120 days of spud date.

A Regular Section of Land 1 Mile = 5,280 Ft.

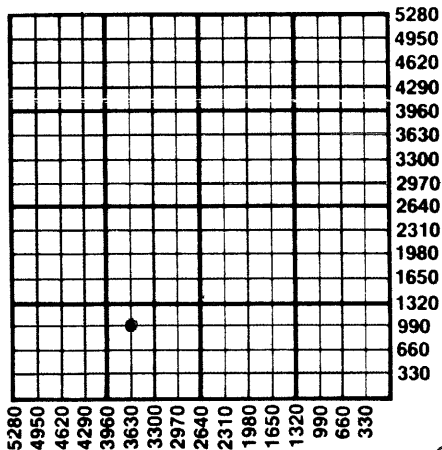

~~1-7-88~~
1-7-88

State Corporation Commission of Kansas
Conservation Division
200 Colorado Derby Building
Wichita, Kansas 67202-1212
(316) 263-3238