

TYPE

NOTICE OF INTENTION TO DRILL

C-1
MI-1221

TO BE FILED WITH THE STATE CORPORATION COMMISSION
PRIOR TO COMMENCEMENT OF WELL

API Number 15-099-21,074
(For office use only) 00-00

1. Operator Cisco Petroleum Company a corp

Address 1410 SE Washington, Bartlesville, Okla
74003

2. Contractor Same

Address "

3. Type of Equipment: Rotary ☒ Cable Tool ☐

4. Well to be Drilled for: Oil ☒ Gas ☐

Disposal ☐ Input ☐ Other ☐

5. Depth of Deepest Fresh Water within 1 mile 14 ft.

6. Depth of Municipal Water Well within 3 miles None ft.

7. Depth to Protect all Fresh Water 100 ft.

8. Amount of Surface Casing to be set 40 ft cement long string ft.

9. Alternate No. 1 to surface No. 2 ☒

Starting Date December 10, 1979

County Labette

Sec 9 Twp 35 S Rge 19E E W
West 650 ft. North 200 ft. to location
Spot Location SE corner Section 9 thence

Nearest Lease Line 200 ft.

Lease Name Adrian Kinser

Well No. Wang #6


Est. Total Depth 500 ft.


REMARKS:

OPERATOR STATES THAT HE WILL COMPLY WITH K. S. A. 53-128

Signature of Operator

[Handwritten Signature]

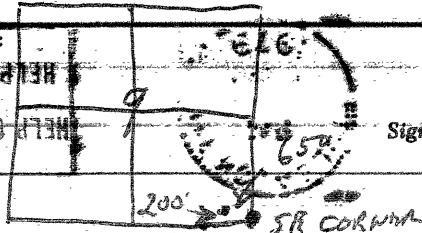

 

State Corporation Commission of Kansas
Conservation Division
245 North Water
Wichita, Kansas 67202

12-7-79
RECEIVED
DEC - 7 1979

(IF PREFERRED, MAIL IN ENVELOPE)