

TYPE

NOTICE OF INTENTION TO DRILL

C-1
MI-1331

**TO BE FILED WITH THE STATE CORPORATION COMMISSION
PRIOR TO COMMENCEMENT OF WELL**

API Number 15-009-21,075
(For office use only) 00 00

1. Operator Cisco Petroleum Company, a corp.

Starting Date December 12, 1979

Address 1410 SE Washington, Bartlesville, Okla.
74003

County Labette

2. Contractor Same

Sec 9 Twp 35 S Rge 19E E
West 485 ft. North 530 ft to location
Spot Location SE corner Section 9 thence

Address "

3. Type of Equipment: Rotary X Cable Tool

4. Well to be Drilled for: Oil X Gas

Nearest Lease Line 530-485 ft.

Disposal Input Other

Lease Name Adrain Kinser

5. Depth of Deepest Fresh Water within 1 mile 14 ft.

6. Depth of Municipal Water Well within 3 miles None ft.

7. Depth to Protect all Fresh Water 100 ft.

8. Amount of Surface Casing to be set 40 ft cement long string ft.


Well No. Wang #8

9. Alternate No. 1 to surface No. 2

Est. Total Depth 500 ft.


REMARKS:

OPERATOR STATES THAT HE WILL COMPLY WITH K. S. A. 55-128

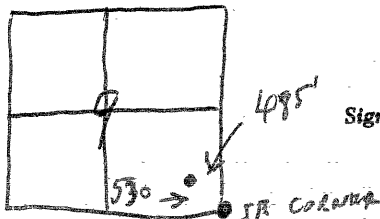

Signature of Operator

James Earl Kinser

 

State Corporation Commission of Kansas
Conservation Division
245 North Water
Wichita, Kansas 67202

12-7-79
RECEIVED
STATE CORPORATION COMMISSION
DEC - 7 - 1979
CONSERVATION DIVISION
WICHITA, KANSAS

(IF PREFERRED, MAIL IN ENVELOPE)