

EL 4853
CARD MUST BE TYPED

State of Kansas
NOTICE OF INTENTION TO DRILL
(see rules on reverse side)

CARD MUST BE SIGNED

Starting Date: April 19, 1985
month day year

API Number 15- 125-27,742-00-00

OPERATOR: License # 6384
Name Gene Nunneley
Address P.O. Box 188
City/State/Zip Caney, Kansas 67333
Contact Person Gene Nunneley
Phone 316-879-2164

East West
NW 1/4 Sec 3 Twp 35 S Rge 14E
4380 Ft North from Southeast Corner of Section
5240 Ft West from Southeast Corner of Section
(Note: Locate well on Section Plat on reverse side)

CONTRACTOR: License # 5989
Name Finney Drilling Company
City/State Route 1, Box 203-2 Wann, OK

Nearest lease or unit boundary line 40 feet
County Montgomery
Lease Name Monk Well# 2A
Domestic well within 330 feet: yes no
Municipal well within one mile: yes no

Well Drilled For: Well Class: Type Equipment:
 Oil Swd Infield Mud Rotary
 Gas Inj Pool Ext. Air Rotary
 OWWO Expl Wildcat Cable

Depth to Bottom of fresh water 40 feet
Lowest usable water formation None
Depth to Bottom of usable water None 175 feet
Surface pipe by Alternate: 1 2
Surface pipe to be set 20 feet
Conductor pipe if any required feet
Ground surface elevation feet MSL

If OWWO: old well info as follows:
Operator
Well Name
Comp Date Old Total Depth
Projected Total Depth 1400 feet
Projected Formation at TD Bartlesville
Expected Producing Formations

This Authorization Expires 10-19-85
Approved By 4-19-85 R

I certify that we will comply with K.S.A. 55-101, et seq., plus eventually plugging hole to K.C.C. specifications.

Date 4-15-85 Signature of Operator or Agent Gene Nunneley Title Operator

WICHITA, KANSAS
DIVISION OF CONSERVATION

Must be filed with the K.C.C. five (5) days prior to commencing well
This card void if drilling not started within six (6) months of date received by K.C.C.

APR 16 1985


4-16-85

STATE CORPORATION COMMISSION

RECEIVED
A Regular Section of Land
1 Mile = 5,280 Ft.

Important procedures to follow :

1. Notify District office before setting surface casing.
2. Set surface casing by circulating cement to the top.
3. File completion forms ACO-1 with K.C.C. within 90 days of well completion, following instructions on ACO-1, side 1, and including copies of wireline logs.
4. Notify District office 48 hours prior to old well workover or re-entry.
5. Prior to plugging, prepare a plugging plan, then obtain agreement from the appropriate district office for an approved plugging plan.
6. Submit plugging report (CP-4) to K.C.C. after plugging is completed.
7. Obtain an approved injection docket number before disposing of salt water.
8. Notify K.C.C. within 10 days when injection commences or terminates.
9. If an alternate 2 completion, cement in the production pipe from below any usable water to surface within 120 days of spud date.

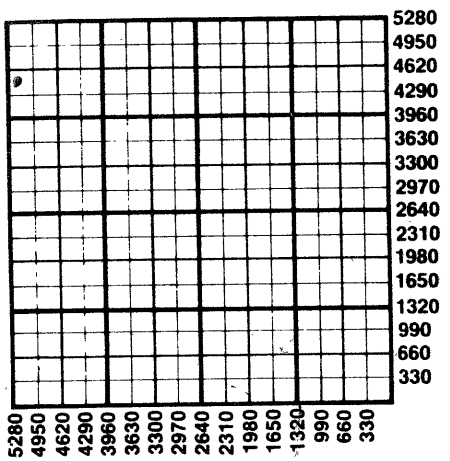

State Corporation Commission of Kansas
Conservation Division
200 Colorado Derby Building
Wichita, Kansas 67202
(316) 263-3238