

CARD MUST BE TYPED

# NOTICE OF INTENTION TO DRILL

State of Kansas  
(see rules on reverse side)

CARD MUST BE SIGNED

Starting Date: 12/20/84  
month day year

API Number 15- 125-27,489-00-00

OPERATOR: License # 5566  
Name Martindale Enterprises, Inc. ~~Arcadia Resources~~  
Address 8222 Douglas #360  
City/State/Zip Dallas, TX 75225  
Contact Person Bill Martindale  
Phone 214/361-1680

NW/4 NE/4 NE/4 Sec 8 Twp 35 S, Rge 15  East  
(location)  West  
5180 Ft North from Southeast Corner of Section  
670 Ft West from Southeast Corner of Section  
(Note: Locate well on Section Plat on reverse side)

CONTRACTOR: License # 5831  
Name Mokat Drilling  
City/State Box 325, Tyro, KS 67364

Nearest lease or unit boundary line 165 feet.  
County Montgomery  
Lease Name A. Bachman Well# 4

Well Drilled For: Well Class: Type Equipment:  
 Oil  Swd  Infield  Mud Rotary  
 Gas  Inj  Pool Ext.  Air Rotary  
 OWWO  Expl  Wildcat  Cable

Domestic well within 330 feet:  yes  no  
Municipal well within one mile:  yes  no  
Depth to Bottom of fresh water 135 feet  
Lowest usable water formation

If OWWO: old well info as follows:  
Operator  
Well Name  
Comp Date Old Total Depth  
Projected Total Depth 1250 feet  
Projected Formation at TD  
Expected Producing Formations

Depth to Bottom of usable water 175 feet  
Surface pipe by Alternate: 1  2   
Surface pipe to be set 20' into solid formation  
not less than 20' feet  
Conductor pipe if any required none feet  
Ground surface elevation 850 feet MSL  
This Authorization Expires 6-14-85  
Approved By 12-14-84

I certify that we will comply with K.S.A. 55-101, et seq., plus eventually plugging hole to K.C.C. specifications.

Date 12/12/84 Signature of Operator or Agent

*Bill Martindale*


Title President

*AMHC/KOHE 12/14/84*

Must be filed with the K.C.C. five (5) days prior to commencing well  
 This card void if drilling not started within six (6) months of date received by K.C.C.

**Important procedures to follow :**

**A Regular Section of Land  
 1 Mile = 5,280 Ft.**

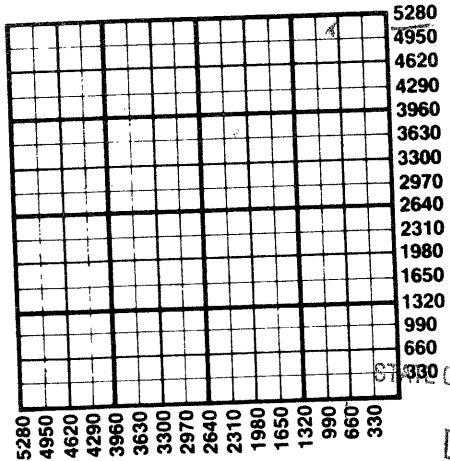

1. Notify District office before setting surface casing.
2. Set surface casing by circulating cement to the top.
3. File completion forms ACO-1 with K.C.C. within 90 days of well completion, following instructions on ACO-1, side 1, and including copies of wireline logs.
4. Notify District office 48 hours prior to old well workover or re-entry.
5. Prior to plugging, prepare a plugging plan, then obtain agreement from the appropriate district office for an approved plugging plan.
6. Submit plugging report (CP-4) to K.C.C. after plugging is completed.
7. Obtain an approved injection docket number before disposing of salt water.
8. Notify K.C.C. within 10 days when injection commences or terminates.
9. If an alternate 2 completion, cement in the production pipe from below any usable water to surface within 120 days of spud date.

RECEIVED

STATE CORPORATION COMMISSION

DEC 14 1984

CONSERVATION DIVISION  
 Wichita, Kansas

12-14-84

State Corporation Commission of Kansas  
 Conservation Division  
 200 Colorado Derby Building  
 Wichita, Kansas 67202  
 (316) 263-3238