

CARD MUST BE TYPED

State of Kansas

CARD MUST BE SIGNED

NOTICE OF INTENTION TO DRILL

(see rules on reverse side)

Starting Date 3 21 86
month day year 3:45

API Number 15— 125-28,311-00-00

OPERATOR: License # 4012
Name Da Co Petroleum
Address Route 1, Box 178-A
City/State/Zip Coffeyville, Ks. 67335
Contact Person Sennis Wooldridge
Phone 918-865-4194

app. NW NE NE Sec. 6 Twp. 35 S, Rg. 15 East
..... 4730 Ft. from South Line of Section
..... 780 Ft. from East Line of Section

(Note: Locate well on Section Plat on reverse side)

CONTRACTOR: License # 5831
Name Mokat
City/State Tyro, Kansas 67362

Nearest lease or unit boundary line 550 feet
County Montgomery
Lease Name McDaniels Well # 4

Well Drilled For: Well Class: Type Equipment:
 Oil SWD Infield Mud Rotary
 Gas Inj Pool Ext. Air Rotary
 OWWO Expl Wildcat Cable

Ground surface elevation feet MSL
Domestic well within 330 feet: yes no
Municipal well within one mile: yes no

IF OWWO: old well info as follows:

Operator
Well Name
Comp Date Old Total Depth

Depth to bottom of fresh water 75
Depth to bottom of usable water 150 75 MIN
Surface pipe by Alternate: 1 2
Surface pipe planned to be set 250
Conductor pipe required
Projected Total Depth 1720 feet
Formation arbuckle

I certify that well will comply with K.S.A. 55-101, et seq., plus eventually plugging hole to KCC specifications.

Date 3-19-86 Signature of Operator or Agent Mona Elmair Title as agent

For KCC Use:


Conductor Pipe Required feet; Minimum Surface Pipe Required 250 feet per Alt. 1
This Authorization Expires 9-19-86 Approved By 3-19-86 *[Signature]*

Must be filed with the K.C.C. five (5) days prior to commencing well
 This card void if drilling not started within six (6) months of date received by K.C.C.

Important procedures to follow:

1. Notify District office before setting surface casing.
2. Set surface casing by circulating cement to the top.
3. File completion forms ACO-1 with K.C.C. within 90 days of well completion, following instructions on ACO-1, side 1, and including copies of wireline logs.
4. Notify District office 48 hours prior to old well workover or re-entry.
5. Prior to filing Intent, prepare a proposed plugging plan in case well is D & A, then obtain approval of plan when calling district office prior to setting surface pipe.
6. Submit plugging report (CP-4) to K.C.C. after plugging is completed.
7. Obtain an approved injection docket number before disposing of salt water.
8. Notify K.C.C. within 10 days when injection commences or terminates.
9. If an alternate 2 completion, cement in the production pipe from below any usable water to surface within 120 days of spud date.

**A Regular Section of Land
 1 Mile = 5,280 Ft.**

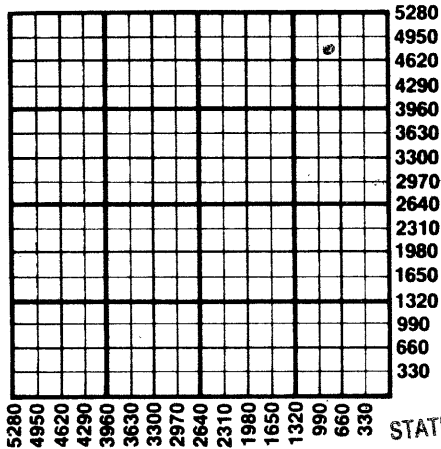

RECEIVED
 STATE CORPORATION COMMISSION

MAR 19 1986
 CONSERVATION DIVISION
 Wichita, Kansas
 3-19-86

State Corporation Commission of Kansas
 Conservation Division
 200 Colorado Derby Building
 Wichita, Kansas 67202
 (316) 263-3238