

CARD MUST BE TYPED

State of Kansas

CARD MUST BE SIGNED

NOTICE OF INTENTION TO DRILL

(see rules on reverse side)

Starting Date 6/14/86
month day year

API Number 15— 125-28,358-0000 ✓
—X East

OPERATOR: License # 4012
Name DaCo Petroleum
Address Route 1, Box 178-A
City/State/Zip Coffeyville, Kansas 67337
Contact Person Darrel Pinkstone
Phone 316-948-6381

.....NW..NE..NE Sec....6. Twp..35. S, Rg...15... — West
..... 4950 Ft. from South Line of Section
..... 990 Ft. from East Line of Section

(Note: Locate well on Section Plat on reverse side)

CONTRACTOR: License # ... 5831
Name Mokat
City/State ... Tyro, Kansas ... 67362

Nearest lease or unit boundary line 990 feet
County Montgomery

Lease Name MCDaniels Well # G-1
Ground surface elevation ... n/a feet MSL

Well Drilled For: Well Class: Type Equipment:
 Oil SWD Infield Mud Rotary
 Gas Inj Pool Ext. Air Rotary
 OWWO Expl Wildcat Cable

Domestic well within 330 feet: —yes no
Municipal well within one mile: —yes no

Depth to bottom of fresh water 75
Depth to bottom of usable water 175

Surface pipe by Alternate: 1 — 2
Surface pipe planned to be set 300

Conductor pipe required n/a
Projected Total Depth 1250 feet

Formation Bartlesville

I certify that well will comply with K.S.A. 55-101, et seq., plus eventually plugging hole to KCC specifications.

Date 6/12/86 Signature of Operator or Agent *Donald Moore* Title as agent

For KCC Use:

Conductor Pipe Required feet; Minimum Surface Pipe Required feet per Alt. *20* & *20*
This Authorization Expires 12-12-86 Approved By *6-12-86* *TC*

Must be filed with the K.C.C. five (5) days prior to commencing well
This card void if drilling not started within six (6) months of date received by K.C.C.


6-12-86

RECEIVED
STATE CORPORATION COMMISSION

A Regular Section of Land

1 Mile = 5,280 Ft.

JUN 12 1986

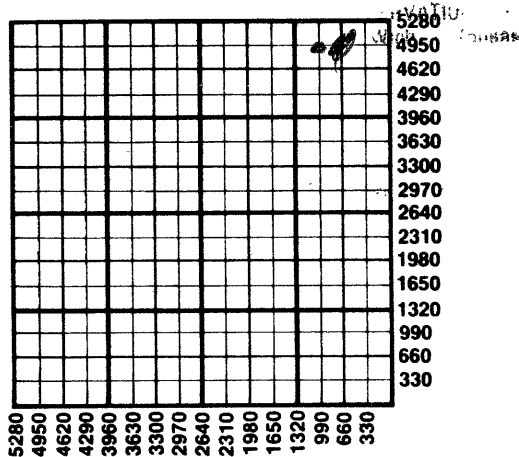

Important procedures to follow:

1. Notify District office before setting surface casing.
2. Set surface casing by circulating cement to the top.
3. File completion forms ACO-1 with K.C.C. within 90 days of well completion, following instructions on ACO-1, side 1, and including copies of wireline logs.
4. Notify District office 48 hours prior to old well workover or re-entry.
5. Prior to filing Intent, prepare a proposed plugging plan in case well is D & A, then obtain approval of plan when calling district office prior to setting surface pipe.
6. Submit plugging report (CP-4) to K.C.C. after plugging is completed.
7. Obtain an approved injection docket number before disposing of salt water.
8. Notify K.C.C. within 10 days when injection commences or terminates.
9. If an alternate 2 completion, cement in the production pipe from below any usable water to surface within 120 days of spud date.

State Corporation Commission of Kansas
Conservation Division
200 Colorado Derby Building
Wichita, Kansas 67202
(316) 263-3238