

CARD MUST BE TYPED

State of Kansas

CARD MUST BE SIGNED

NOTICE OF INTENTION TO DRILL

(see rules on reverse side)

Starting Date ..... JULY 25, 1986
month day year

API Number 15- 125-28,391-00-00

OPERATOR: License # 08335
Name Western Fuel & Supply Co.
Address 619 Union St., P. O. Box 783
City/State/Zip Coffeyville, KS 67337
Contact Person Randall H. Borum
Phone 316-251-6064

NE SE NE Sec. 6... Twp. 35.. S, Rg. 15... East
3386 Ft. from South Line of Section
825 Ft. from East Line of Section

(Note: Locate well on Section Plat on reverse side)

CONTRACTOR: License # 05831
Name Mokat Drilling Co., Inc.
City/State Caney, KS 67333

Nearest lease or unit boundary line East 825 feet
County Montgomery

Lease Name South McDaniels. Well # M-4
Ground surface elevation 867 feet MSL

Well Drilled For: Well Class: Type Equipment:
Oil SWD Infield Mud Rotary
Gas Inj Pool Ext Air Rotary
OWWO Expl Wildcat Cable

Domestic well within 330 feet: yes no
Municipal well within one mile: yes no

If OWWO: old well info as follows:

Operator
Well Name
Comp Date Old Total Depth

Depth to bottom of fresh water 180
Depth to bottom of usable water 180-175-230
Surface pipe by Alternate: 1 + 2
Surface pipe planned to be set 250
Conductor pipe required N/A
Projected Total Depth 1745 feet
Formation Arbuckle Lime

I certify that well will comply with K.S.A. 55-101, et seq., plus eventually plugging hole to KCC specifications.

Date 7/23/86 Signature of Operator or Agent Randall H. Borum Title Owner

For KCC Use:

Conductor Pipe Required feet; Minimum Surface Pipe Required 250 feet per Alt. 1
This Authorization Expires 7-24-87 Approved By 7-24-86

Handwritten signature: RCH/KCC

Must be filed with the K.C.C. five (5) days prior to commencing well  
This card void if drilling not started within six (6) months of date received by K.C.C.


### Important procedures to follow:

1. Notify District office before setting surface casing.
2. Set surface casing by circulating cement to the top.
3. File completion forms ACO-1 with K.C.C. within 90 days of well completion, following instructions on ACO-1, side 1, and including copies of wireline logs.
4. Notify District office 48 hours prior to old well workover or re-entry.
5. Prior to filing Intent, prepare a proposed plugging plan in case well is D & A, then obtain approval of plan when calling district office prior to setting surface pipe.
6. Submit plugging report (CP-4) to K.C.C. after plugging is completed.
7. Obtain an approved injection docket number before disposing of salt water.
8. Notify K.C.C. within 10 days when injection commences or terminates.
9. If an alternate 2 completion, cement in the production pipe from below any usable water to surface within 120 days of spud date.

### A Regular Section of Land

1 Mile = 5,280 Ft.

McDANIELS SOUTH LEASE

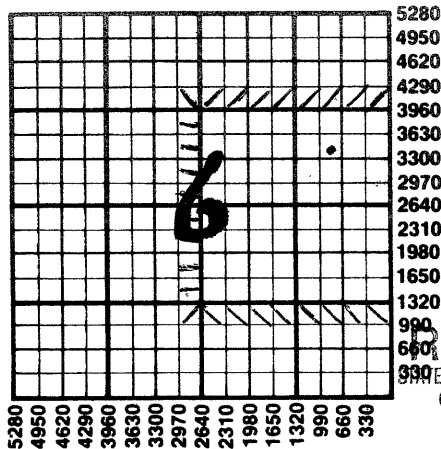

RECEIVED  
STATE CORPORATION COMMISSION  
CONS. DIV. WICHITA, KS

State Corporation Commission of Kansas  
Conservation Division  
200 Colorado Derby Building  
Wichita, Kansas 67202  
(316) 263-3238

JUL 24 1986  
724-86