

CARD MUST BE TYPED

State of Kansas

CARD MUST BE SIGNED

NOTICE OF INTENTION TO DRILL

(see rules on reverse side)

Starting Date 7-31-86
month day year 11:15OPERATOR: License # 4012
Name DaCo Petroleum Inc.
Address Route 1, Box 178-A
City/State/Zip Coffeyville, Kansas 67337
Contact Person Darrel Pinkstone
Phone (316) 948-6381CONTRACTOR: License # 5831
Name MOKAT
City/State Box 325, Tyro, Kansas 67362Well Drilled For: Well Class: Type Equipment:
☒ Oil ☐ SWD ☒ Infield ☐ Mud Rotary
☒ Gas ☐ Inj ☐ Pool Ext. ☒ Air Rotary
☐ OWWO ☐ Expl ☐ Wildcat ☐ Cable

If OWWO: old well info as follows:

Operator
Well Name
Comp Date Old Total Depth

I certify that well will comply with K.S.A. 55-101, et seq., plus eventually plugging hole to KCC specifications.

Date 7/31/86... Signature of Operator or Agent LuAnne Corliss Title As. Agent

For KCC Use:

Conductor Pipe Required feet; Minimum Surface Pipe Required 20 feet per Alt. 42
This Authorization Expires 1-31-87 Approved By 7-31-86
RCH/KCCAPI Number 15— 125-28,394-00-00
NW SE NE Sec. 6 Twp. 35 S, Rg. 15
3840
790
Ft. from South Line of Section
Ft. from East Line of Section

(Note: Locate well on Section Plat on reverse side)


Nearest lease or unit boundary line 790 feet
County Montgomery
Lease Name McDaniels Well # G-6
Ground surface elevation n/a feet MSL
Domestic well within 330 feet: ☐ yes ☒ no
Municipal well within one mile: ☐ yes ☒ no
Depth to bottom of fresh water 75
Depth to bottom of usable water 175
Surface pipe by Alternate: 1 ☐ 2 ☒
Surface pipe planned to be set 300
Conductor pipe required n./a
Projected Total Depth 1250 feet
Formation Bartlesville

Must be filed with the K.C.C. five (5) days prior to commencing well
This card void if drilling not started within six (6) months of date received by K.C.C.

Important procedures to follow:

1. Notify District office before setting surface casing.
2. Set surface casing by circulating cement to the top.
3. File completion forms ACO-1 with K.C.C. within 90 days of well completion, following instructions on ACO-1, side 1, and including copies of wireline logs.
4. Notify District office 48 hours prior to old well workover or re-entry.
5. Prior to filing Intent, prepare a proposed plugging plan in case well is D & A, then obtain approval of plan when calling district office prior to setting surface pipe.
6. Submit plugging report (CP-4) to K.C.C. after plugging is completed.
7. Obtain an approved injection docket number before disposing of salt water.
8. Notify K.C.C. within 10 days when injection commences or terminates.
9. If an alternate 2 completion, cement in the production pipe from below any usable water to surface within 120 days of spud date.

A Regular Section of Land 1 Mile = 5,280 Ft.

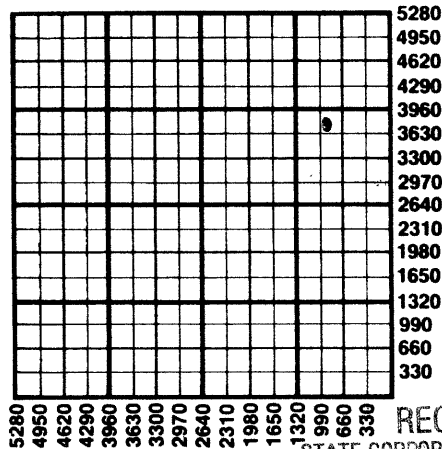

RECEIVED
STATE CORPORATION COMMISSION

JUL 31 1986

CONSERVATION DIVISION
Wichita, Kansas

7-31-86

State Corporation Commission of Kansas
Conservation Division
200 Colorado Derby Building
Wichita, Kansas 67202
(316) 263-3238