

STATE OF KANSAS  
STATE CORPORATION COMMISSION


WELL PLUGGING RECORD

Give All Information Completely  
Make Required Affidavit  
Mail or Deliver Report to:  
Conservation Division  
State Corporation Commission  
800 Biting Building  
Wichita, Kansas

Rooks County, Sec. 35 Twp. 9 Rge. 20 (E) (W)

Location as "NE/CNW $\frac{1}{4}$ SW $\frac{1}{4}$ " or footage from lines NW $\frac{1}{4}$ SW $\frac{1}{4}$ NE $\frac{1}{4}$   
Lease Owner I. O. Miller  
Lease Name Pywell B Well No. 2B  
Office Address P.O. Box 74, Ellis, Kansas  
Character of Well (completed as Oil, Gas or Dry Hole) Dry Hole  
Date well completed Oct. 15 1954  
Application for plugging filed Oct. 15, 1954  
Application for plugging approved Oct. 15, 1954  
Plugging commenced 11 AM, Oct. 15, 1954  
Plugging completed 3 PM, Oct. 15, 1954  
Reason for abandonment of well or producing formation Dry Hole

NORTH

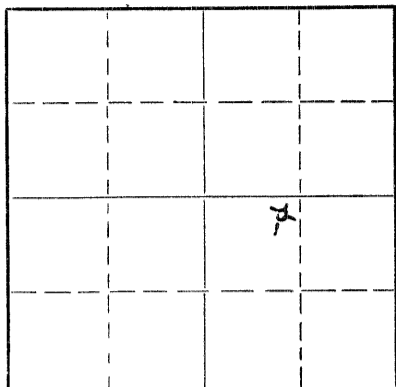

Locate well correctly on above  
Section Plat

If a producing well is abandoned, date of last production \_\_\_\_\_ 19\_\_\_\_  
Was permission obtained from the Conservation Division or its agents before plugging was commenced? Yes

Name of Conservation Agent who supervised plugging of this well Eldon Petty  
Producing formation None Depth to top \_\_\_\_\_ Bottom \_\_\_\_\_ Total Depth of Well \_\_\_\_\_ Feet  
Show depth and thickness of all water, oil and gas formations.

OIL, GAS OR WATER RECORDS

CASING RECORD

FORMATION	CONTENT	FROM	TO	SIZE	PUT IN	PULLED OUT

Describe in detail the manner in which the well was plugged, indicating where the mud fluid was placed and the method or methods used in introducing it into the hole. If cement or other plugs were used, state the character of same and depth placed, from \_\_\_\_\_ feet to \_\_\_\_\_ feet for each plug set.

Hole filled to 210' from top with heavy mud and bottom plug set.  
 $\frac{1}{2}$  sack of hulls put on top of plug, followed by 15 sacks of cement.  
Hole filled with heavy mud to 40' from top and set top plug.  $\frac{1}{2}$  sack of hulls placed above plug, followed by 10 sacks of cement.

10-17-54

(If additional description is necessary, use BACK of this sheet)

Name of Plugging Contractor Virginia Drilling Company  
Address 701 Brown Bldg., Wichita, Kansas

STATE OF Kansas, COUNTY OF Rooks, ss.  
Paul W. Miller (employee of owner) or (owner or operator) of the above-described well, being first duly sworn on oath, says: That I have knowledge of the facts, statements, and matters herein contained and the log of the above-described well as filed and that the same are true and correct. So help me God.

(Signature) Paul W. Miller

SUBSCRIBED AND SWORN to before me this 16<sup>th</sup> day of October, 1954

(Address) \_\_\_\_\_  
Eva M. Marion  
Notary Public.

My commission expires July 27, 1957

24-2675-S 2-52-20M

**PLUGGING**  
FILE SEC 35 T 9 R 20W  
BOOK PAGE 70 LINE 45

Well: Pywell B # 2  
 Location: NW SW NE/4 Section 35-9-20, Rooks County, Kansas  
 Company: I. O. Miller  
 Contractor: Virginia Drilling Co., Inc.  
 Commenced: October 5, 1954  
 Completed: October 16, 1954  
 Elevation: 2233 D. F.  
 Rotary Total Depth: 3861

FORMATION	DEPTH	
Sand-shale	0-60	
Shale	60-218	
Shale-shells	218-650	
Shale	650-910	
Shale-sand	910-1410	
Shale-red bed	1410-1460	
Shale	1460-1686	Set 218' of 8-5/8" csg.
Anhydrite	1686-1735	
Lime-shale	1735-2570	
Lime	2570-2635	
Shale-shells	2635-2805	TOPS:
Lime-shale	2805-3040	Topeka 3286
Shale-shells	3040-3205	Hebner 3458
Lime-shale	3205-3464	Toronto 3481
Lime	3464-3700	Kansas City 3498
Lime-shale	3700-3747	Base Kansas City 3718
Lime-conglomerate	3747-3795	Conglomerate 3759
Lime-chert	3795-3825	Arbuckle 3851
Chert	3825-3861	

Now comes S. A. Murphy, who states that he is familiar with the drilling of oil and gas wells and knows of his own knowledge that the Pywell B #2, located NW SW NE/4 Section 35-9-20, Rooks County, Kansas, was drilled to a total depth of 3861 feet. Same was plugged and abandoned.

*S. A. Murphy*

Subscribed and sworn to before me this 28th day of October, 1954.

*Henry M. Underwood*

My commission expires March 15, 1958.

## PAUL W. MILLER

P. O. BOX 236  
 PALCO, KANSAS  
 Oct. 16, 1954

State Corporation Commission  
 Conservation Division  
 Wichita, Kansas

Lease Owner: I. O. Miller  
 Lease: Pywell B  
 Pool: Northampton SE  
 Well number: B 2  
 Description: NW $\frac{1}{4}$ SW $\frac{1}{4}$ NE $\frac{1}{4}$   
 Sec. 35-9-20W

Gentlemen:

The following is a log of the above captioned  
 dry hole:

	Elevation	2236 KB
Heebner	3458	-1222
Toronto	3481	-1245
Lansing	3498	-1262
Base Lansing	3718	-1482
Arbuckle	3851	-1615
Conglomerate	3759	-1523
T.D.	3861	

This log is attached to Well Plugging  
 Application Form.

Yours truly,

I. O. Miller

By Paul W. Miller  
 Sup't.

