


STATE OF KANSAS  
STATE CORPORATION COMMISSION

Give All Information Completely  
Make Required Affidavit  
Mail or Deliver Report to:  
Conservation Division  
State Corporation Commission  
211 No. Broadway  
Wichita, Kansas

WELL PLUGGING RECORD

NORTH

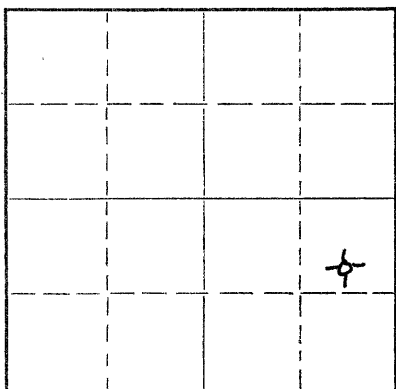

Locate well correctly on above  
Section Plat

Graham County. Sec. 7 Twp. 9S Rge. (E) 21(W)

Location as "NE/CNW/SW" or footage from lines. CS/2 NE SE

Lease Owner Peel-Hardman Oil Operators

Lease Name Cooley Well No. 2

Office Address R. R. #3, Box 144B, Wichita, Kansas

Character of Well (completed as Oil, Gas or Dry Hole) Oil Well

Date well completed July 11, 1953

Application for plugging filed June 2, 1956

Application for plugging approved June 5, 1956

Plugging commenced July 12, 1956

Plugging completed July 16, 1956

Reason for abandonment of well or producing formation No longer produces sufficient oil to be a commercial producer

If a producing well is abandoned, date of last production March 28, 1956

Was permission obtained from the Conservation Division or its agents before plugging was commenced? Yes

Name of Conservation Agent who supervised plugging of this well Eldon Petty

Producing formation Arbuckle Depth to top 3772 Bottom 3775 Total Depth of Well 3775 Feet

Show depth and thickness of all water, oil and gas formations. D. F. D. F. D. F.

OIL, GAS OR WATER RECORDS

CASING RECORD

FORMATION	CONTENT	FROM	TO	SIZE	PUT IN	PULLED OUT
		0	168' DF	8 5/8"	168'	None
		0	3772 1/2' DF	5 1/2"	3772 1/2' DF	2866'

Describe in detail the manner in which the well was plugged, indicating where the mud fluid was placed and the method or methods used in introducing it into the hole. If cement or other plugs were used, state the character of same and depth placed, from \_\_\_\_\_ feet to \_\_\_\_\_ feet for each plug set.

Set six sacks cement on bottom. Shot pipe off at 2866'. Pulled pipe and mudded hole to 180'. Set rock bridge and dumped 15 sacks of cement. Finished mudding hole and set rock bridge at 35'. Dumped 10 sacks of cement at top.

(If additional description is necessary, use BACK of this sheet)

Name of Plugging Contractor Bert Self

Address R. R. #4, Hutchinson, Kansas

STATE OF Kansas, COUNTY OF Barton, ss.

William Herbert (employee of owner) Peel-Hardman Oil Operators of the above-described well, being first duly sworn on oath, says: That I have knowledge of the facts, statements and matters herein contained and the log of the above-described well as filed and that the same are true and correct. So help me God.

(Signature) [Signature]

R. R. #3, Box 144B, Wichita, Kansas (Address)

SUBSCRIBED AND SWORN TO before me this 27th day of August, 1956

My commission expires June 4, 1959.

[Signature] Notary Public.

8/29/56

PLUGGING  
FILE SEC 7 T 9 R 21W  
BOOK PAGE 67 LINE 42

DRILLER'S LOG

Company: Peel-Hardman Oil Producers

Farm: Cooley Well No. 2  
 Total Depth: 3777'

Comm: 6-29-53 Comp: 7-8-53  
 Contractor: Peel Brothers, Inc.

Casing:  
 8 5/8" 170' cem.  
 5 1/2 " 3774.50' cem.

*es/2* SE  
~~S~~ NE ~~S~~  
 Sec. 7, Twp. 9S, Rgel. 21W  
 County: Graham,  
 Kansas

Elevation:

Production:

Figures below indicate bottom of formations

Sand & Shale	0 -	175
Shale		1064
Shale & Sand		1690
Shale		1740
Anhydrite		1770
Shale & Shells		2270
Shale & Lime		2460
Shale & Shells		2750
Shale & Lime		3491
Lime		3774
Dolomite		3777
Arbuckle		3777
Total Depth		3777

This is to certify that the above information is to the best of my knowledge true and correct.

PEEL BROTHERS, INC.

BY: *[Signature]*

SUBSCRIBED AND SWORN to before me this 9<sup>th</sup> day of July, 1953.

My commission expires January 9, 1957 *[Signature]*  
 Notary Public

**PLUGGING**  
 FILE SEC 7 T 9 R 21W  
 BOOK PAGE 67 LINE 42