


STATE OF KANSAS  
STATE CORPORATION COMMISSION

Give All Information Completely  
Make Required Affidavit  
Mail or Deliver Report to:  
Conservation Division  
State Corporation Commission  
211 No. Broadway  
Wichita, Kansas

WELL PLUGGING RECORD

NORTH

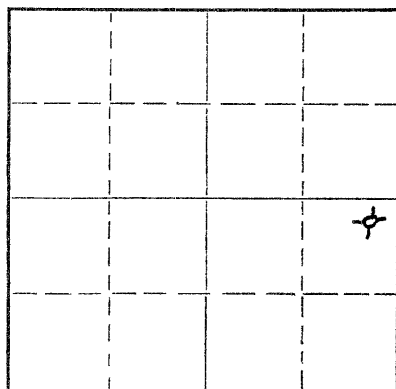

Locate well correctly on above  
Section Plat

Graham County. Sec. 7 Twp. 9S Rge. (E) 21 (W)  
Location as "NE/CNW/SW" or footage from lines NE NE SE  
Lease Owner Peel-Hardman Oil Operators  
Lease Name Gooley Well No. 1  
Office Address R. R. #3, Box 144B, Wichita, Kansas  
Character of Well (completed as Oil, Gas or Dry Hole) Oil Well  
Date well completed April 15, 19 53  
Application for plugging filed June 2, 19 56  
Application for plugging approved June 5, 19 56  
Plugging commenced July 16, 19 56  
Plugging completed July 19, 19 56  
Reason for abandonment of well or producing formation No longer produces sufficient oil to be a commercial producer  
If a producing well is abandoned, date of last production March 11, 19 56  
Was permission obtained from the Conservation Division or its agents before plugging was commenced? Yes

Name of Conservation Agent who supervised plugging of this well Eldon Petty  
Producing formation Arbuckle Depth to top 3787 Bottom 3790 Total Depth of Well 3790 Feet  
Show depth and thickness of all water, oil and gas formations.

OIL, GAS OR WATER RECORDS

CASING RECORD

| FORMATION | CONTENT | FROM | TO        | SIZE   | PUT IN    | PULLED OUT |
|-----------|---------|------|-----------|--------|-----------|------------|
|           |         | 0    | 183'      | 8 5/8" | 183'      | None       |
|           |         | 0    | 3787 1/2' | 5 1/2" | 3787 1/2' | 2743'      |
|           |         |      |           |        |           |            |
|           |         |      |           |        |           |            |
Describe in detail the manner in which the well was plugged, indicating where the mud fluid was placed and the method or methods used in introducing it into the hole. If cement or other plugs were used, state the character of same and depth placed, from \_\_\_\_\_ feet to \_\_\_\_\_ feet for each plug set.

Dumped six sacks of cement in bottom of hole. Shot pipe off at 2743'. Filled pipe and mudded hole to 180'. Set rock bridge and dumped 15 sacks of cement. Mudded hole to 35'. Set rock bridge and dumped 10 sacks of cement at top.

(If additional description is necessary, use BACK of this sheet)

Name of Plugging Contractor Bert Self  
Address R. R. #2, Hutchinson, Kansas

STATE OF Kansas, COUNTY OF Barton, ss.  
William Herbert (employee of owner) ~~Peel-Hardman Oil Operators~~ of the above-described well, being first duly sworn on oath, says: That I have knowledge of the facts, statements, and matters herein contained and the log of the above-described well as filed and that the same are true and correct. So help me God.

(Signature) William Herbert  
R. R. #3, Box 144B, Wichita, Kansas  
(Address)

SUBSCRIBED AND SWORN TO before me this 19th day of August, 19 56

My commission expires June 4, 1959.

Marian M. Herbert  
Notary Public.

RECEIVED  
STATE CORPORATION COMMISSION  
8/29/56  
AUG 29 1956  
CONSERVATION DIVISION

PLUGGING  
FILE SEC 7 T 9 R21W  
BOOK PAGE 67 LINE 43

DRILLER'S LOG

Company: Peal-Hardman Oil Prod.

NE 1/4 SE

Farm: Cooley Well No. 1

Sec. 7, Twp. 9S, Rge. 21W,

Total Depth: 3790'

County: Graham,

Kansas

Comm: 4-2-53 Comp: 4-11-53

Contractor: Peal Brothers, Inc.

Elevation:

Casing:

8 5/8" 185' Con.  
 5 1/2" 3787.50 Con.

Production:

Figures below indicate bottom of formations

|                     |      |
|---------------------|------|
| Sand & Sill         | 15   |
| Foot Rock           | 40   |
| Shale               | 185  |
| Shale & Sand        | 685  |
| Shale               | 900  |
| Sand                | 1100 |
| Shale               | 1170 |
| Sandy Shale         | 1200 |
| Sand                | 1480 |
| Shale & Red Bed     | 1750 |
| Anhydrite           | 1790 |
| Red Bed & Shale     | 2080 |
| Shale               | 2210 |
| Shale & Shells      | 2705 |
| Shale & Lins Shells | 2900 |
| Lins & Shale        | 3388 |
| Lins                | 3655 |
| Lins & Shale        | 3718 |
| Lins                | 3790 |
| Belemnite           | 3790 |
| Total Depth         | 3790 |

This is to certify that the above information is to the best of my knowledge true and correct.

PEAL BROTHERS, INC.

BY: [Signature]

SUBSCRIBED AND SWORN to before me this 13<sup>th</sup> day of April, 1953.

My commission expires January 2, 1957 [Signature]  
 Notary Public

Worked in Cable Tools 4-13-53; mudded hole down and drilled cement and shoes; cleaned out to bottom, mudded hole down and acidized w/500 gals. 4-15-53; mud tested well, made approximately 15 blis. oil per hr.; run tubing and rods in well and completed same 4-17-53.

REF  
 STATE

**PLUGGING**  
 FILE SEC 7 T 9 R 21W  
 BOOK PAGE 67 LINE 43