


STATE OF KANSAS  
STATE CORPORATION COMMISSION

Give All Information Completely  
Make Required Affidavit  
Mail or Deliver Report to:  
Conservation Division  
State Corporation Commission  
211 No. Broadway  
Wichita, Kansas

WELL PLUGGING RECORD

NORTH

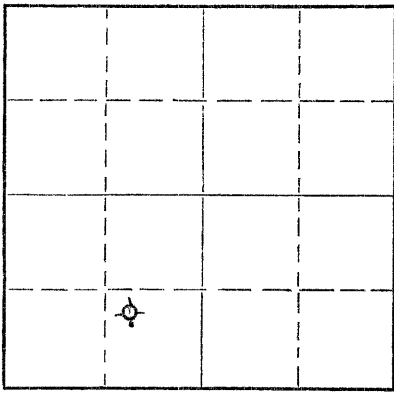

Locate well correctly on above  
Section Plat

Graham County. Sec. 7 Twp. 9 Rge. 21W (E) (W)  
Location as "NE/CNW/SW" or footage from lines NW SE SW  
Lease Owner C-G Drilling Co., D.G. Hansen & Holly Oil Company  
Lease Name Cooley Well No. 3  
Office Address 107 Rule Bldg., Wichita, Kansas  
Character of Well (completed as Oil, Gas or Dry Hole) Dry Hole  
Date well completed August 2 1957  
Application for plugging filed August 2 1957  
Application for plugging approved August 2 1957  
Plugging commenced August 3 1957  
Plugging completed August 3 1957  
Reason for abandonment of well or producing formation Too low structually

If a producing well is abandoned, date of last production \_\_\_\_\_ 19\_\_\_\_  
Was permission obtained from the Conservation Division or its agents before plugging was commenced? Yes

Name of Conservation Agent who supervised plugging of this well Eldon Petty, Hays, Kansas  
Producing formation \_\_\_\_\_ Depth to top \_\_\_\_\_ Bottom \_\_\_\_\_ Total Depth of Well 3842 Feet  
Show depth and thickness of all water, oil and gas formations.

OIL, GAS OR WATER RECORDS

CASING RECORD

FORMATION	CONTENT	FROM	TO	SIZE	PUT IN	PULLED OUT
				8-5/8"	213'	none

Describe in detail the manner in which the well was plugged, indicating where the mud fluid was placed and the method or methods used in introducing it into the hole. If cement or other plugs were used, state the character of same and depth placed, from \_\_\_\_\_ feet to \_\_\_\_\_ feet for each plug set.

Filled hole with heavy mud to 210'. Set plug. Put in 1/2 sack Hulls and 20 sacks cement. Filled with heavy mud up to 40'. Set plug. Filled to top with 1/2 sack Hulls and 10 sacks cement.

(If additional description is necessary, use BACK of this sheet)

Name of Plugging Contractor C-G Drilling Co.  
Address 107 Rule Bldg., Wichita, Kansas

STATE OF KANSAS, COUNTY OF SEDGWICK, ss.  
G. F. Galloway (employee of owner) or (owner or operator) of the above-described well, being first duly sworn on oath, says: That I have knowledge of the facts, statements, and matters herein contained and the log of the above-described well as filed and that the same are true and correct. So help me God.

(Signature) G. F. Galloway  
107 Rule Bldg.  
(Address)

SUBSCRIBED AND SWORN to before me this 6th day of August, 1957

My commission expires May 20, 1959

Vicky Jacobs  
Vicky Jacobs  
Notary Public.

PLUGGING  
FILE SEC 1 T 9 R 21W  
BOOK PAGE 34 LINE 15

8/9/57

15-065-02314-00-00

CONTRACTOR'S WELL LOG

OPERATOR C-G Drilling Co., D. G. Hansen & Holly Oil Company WELL NAME Cooley #3  
 LOCATION NW/4 SE/4 SW/4 Section 7-9S-21W RIG NO. 1  
 COUNTY Graham STATE Kansas  
 COMMENCEMENT DATE July 25, 1957 COMPLETION DATE August 2, 1957

LOG OF WELL

Elevation 2303' rotary bushing.  
 All measurements taken from the top of rotary bushing.

FROM	TO	FORMATION	DEVIATION FROM M VERTICAL	REMARKS:
0	213	Surface Soil		
213	800	Shale		
800	1205	Sand-Shale		
1205	1540	Sand		
1540	1790	Red Bed		
1790	1828	Anhydrite		
1828	2300	Shale		
2300	2460	Lime-Shale		
2460	2585	Lime-Shale	0° - 2500	
2585	2780	Lime-Shale	0° - 2750	
2780	2920	Lime-Shale		
2920	3015	Lime-Shale	0° - 3000	
3015	3265	Lime-Shale	0° - 3250	
3265	3465	Lime-Shale		
3465	3530	Lime-Shale	0° - 3500	
3530	3555	Lime-Shale		DST 3530-3555
3555	3610	Lime-Shale		DST 3586-3599
3610	3740	Lime-Shale		
3740	3824	Lime-Shale	0° - 3750	
3824	3842	Lime-Chert		DST 3837-3842

CASING LEFT IN HOLE AFTER COMPLETION  
 Set 213' (11 jts.) 8-5/8" OD Surface Casing.

STATE OF KANSAS }  
 COUNTY OF SEDGWICK } ss

The undersigned hereby certifies that to the best of his knowledge and belief, the above facts are true and correct.

C-G DRILLING CO.  
 By G. F. Galloway  
 G. F. Galloway

Subscribed and sworn to before me this 6th day of August, 1957.

Vicky Jacobs  
 Vicky Jacobs, Notary Public

My Commission expires: May 20, 1959

RECEIVED  
 STATE CORPORATION COMMISSION

AUG 9 1957

REGISTRATION DIVISION  
 Topeka, Kansas

PLUGGING  
 FILE SEC 7 T 9 R 21W  
 BOOK PAGE 34 LINE 15