

15-065-19725-00-06


STATE OF KANSAS
STATE CORPORATION COMMISSION

WELL PLUGGING RECORD

Give All Information Completely
Make Required Affidavit
Mail or Deliver Report to:
Conservation Division
State Corporation Commission
800 Biting Building
Wichita, Kansas

Graham County. Sec. 7 Twp. 9 Rge. 21 (E) W (W)
Location as "NE/CNW/SW" or footage from lines NW SW NW
Lease Owner C-G Drilling Co.
Lease Name Shaw Well No. 2
Office Address 107 Rule Bldg., Wichita, Kansas
Character of Well (completed as Oil, Gas or Dry Hole) Dry Hole
Date well completed November 14 1955
Application for plugging filed November 14 1955
Application for plugging approved November 14 1955
Plugging commenced November 15 1955
Plugging completed November 15 1955
Reason for abandonment of well or producing formation Too Low structurally

NORTH

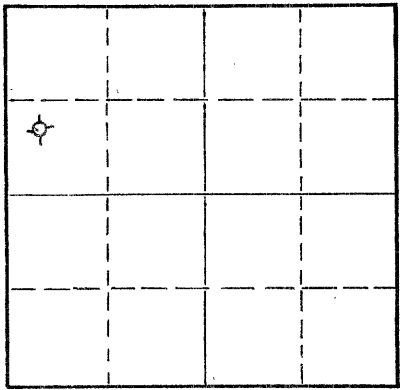

Locate well correctly on above Section Plat

If a producing well is abandoned, date of last production _____ 19____
Was permission obtained from the Conservation Division or its agents before plugging was commenced? Yes

Name of Conservation Agent who supervised plugging of this well Eldon Petty, Hays, Kansas
Producing formation _____ Depth to top _____ Bottom _____ Total Depth of Well 3858 Feet
Show depth and thickness of all water, oil and gas formations.

OIL, GAS OR WATER RECORDS

CASING RECORD

FORMATION	CONTENT	FROM	TO	SIZE	PUT IN	PULLED OUT
				8-5/8"	169'	none

Describe in detail the manner in which the well was plugged, indicating where the mud fluid was placed and the method or methods used in introducing it into the hole. If cement or other plugs were used, state the character of same and depth placed, from _____ feet to _____ feet for each plug set.

Filled hole with heavy mud to 160'. Set plug. Put in 15 sacks of cement. Filled with heavy mud to 40'. Set plug. Filled to top with 10 sacks of cement.

(If additional description is necessary, use BACK of this sheet)

Name of Plugging Contractor C-G Drilling Co.
Address 107 Rule Building, Wichita, Kansas

STATE OF Kansas, COUNTY OF Sedgwick, ss.
Jay H. Galloway (employee of owner) or (owner or operator) of the above-described well, being first duly sworn on oath, says: That I have knowledge of the facts, statements, and matters herein contained and the log of the above-described well as filed and that the same are true and correct. So help me God.

(Signature) Jay H. Galloway
Jay H. Galloway
107 Rule Building
(Address)

SUBSCRIBED AND SWORN to before me this 22nd day of November 1955

Vicky Jacobs
Vicky Jacobs
Notary Public.

My commission expires May 20, 1959

PLUGGING
FILE REC 21 9R 210
BOOK PAGE 17 LINE 17

RECEIVED
STATE CORPORATION COMMISSION
NOV 23 1955
WICHITA, KANSAS

CONTRACTOR'S WELL LOG

OPERATOR C- G DRILLING CO. WELL NAME SHAW #2

LOCATION NW SW NW Sec 7-9-21W RIG #2

COUNTY GRAHAM STATE KANSAS

COMMENCEMENT DATE NOVEMBER 4, 1955 COMPLETION DATE NOVEMBER 15, 1955

LOG OF WELL

Elevation 2274' rotary bushing. All measurements from the top of rotary bushing.

FROM	TO	FORMATION	DEVIATION FROM VERTICAL	REMARKS
0	90	Sand-Shale		
90	165	Shale-Shells		
165	750	Shale		
750	1020	Sand-Shale		
1020	1500	Sand-Shale		
1500	1540	Shale-		
1540	1765	Shale-Shells-Red Bed		
1765	2200	Shale-Shells		
2200	2450	Shale-Lime		
2450	2480	Shale-Lime		
2480	2640	Lime	0° - 2500'	
2640	2780	Shale-Lime		
2780	2950	Shale-Lime		
2950	3125	Shale-Lime	0° - 3000'	
3125	3342	Shale-Lime		
3342	3474	Shale-Lime		
3474	3517	Shale-Lime	0° - 3500'	
3517	3572	Lime		
3572	3678	Lime		
3678	3733	Lime		
3733	3812	Shale-Lime		
3812	3834	Shale-Lime		
3834	3858	Lime		
	3858	TD		

CASING LEFT IN HOLE AFTER COMPLETION

165' of 8-5/8" OD Surface Casing

STATE OF KANSAS, COUNTY OF SEDGWICK) ss.

The undersigned certifies that to the best of his knowledge and belief, the above facts are true and correct.

C-G DRILLING CO.

By Jay H. Galloway

Subscribed and sworn to before me this 18th day of November, 1955.

My commission expires: May 20, 1955

Vicky Jacobs Notary Public

NOV 23 1955 CONSERVATION DIVISION WICHITA, KANSAS

PLUGGING FILE SEC 7-9-21W BOOK PAGE 12 LINE 17