

STATE OF KANSAS  
STATE CORPORATION COMMISSION


WELL PLUGGING RECORD

Give All Information Completely  
Make Required Affidavit  
Mail & Deliver Report to:  
Conservation Division  
State Corporation Commission  
211 No. Broadway  
Wichita, Kansas

Rooks County. Sec. 22 Twp. 9 Rge. 19 (E) W (W)

Location as "NE/CNW/SW" or footage from lines NE NW SE  
Lease Owner Sterling, Drilling Co.  
Lease Name Bartos "B" #1 Well No. \_\_\_\_\_  
Office Address Sterling, Kansas  
Character of Well (completed as Oil, Gas or Dry Hole) \_\_\_\_\_  
Date well completed \_\_\_\_\_ 19\_\_\_\_  
Application for plugging filed \_\_\_\_\_ 19\_\_\_\_  
Application for plugging approved \_\_\_\_\_ 19\_\_\_\_  
Plugging commenced 9-26-58 \_\_\_\_\_ 19\_\_\_\_  
Plugging completed 9-30-58 \_\_\_\_\_ 19\_\_\_\_  
Reason for abandonment of well or producing formation \_\_\_\_\_  
If a producing well is abandoned, date of last production \_\_\_\_\_ 19\_\_\_\_  
Was permission obtained from the Conservation Division or its agents before plugging was commenced? yes

NORTH

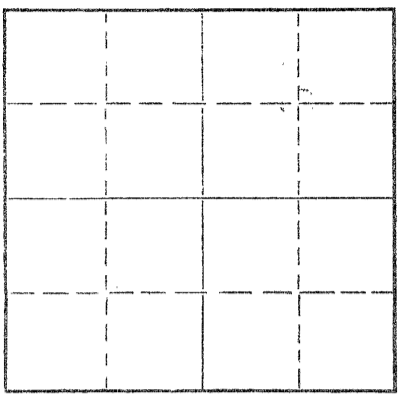

Locate well correctly on above Section Plat

Name of Conservation Agent who supervised plugging of this well Eldon Petty  
Producing formation \_\_\_\_\_ Depth to top \_\_\_\_\_ Bottom \_\_\_\_\_ Total Depth of Well 3606' Feet  
Show depth and thickness of all water, oil and gas formations.

OIL, GAS OR WATER RECORDS

CASING RECORD

FORMATION	CONTENT	FROM	TO	SIZE	PUT IN	PULLED OUT
				8-5/8"	200'	none
				5-1/2"	3585'	1183'

Describe in detail the manner in which the well was plugged, indicating where the mud fluid was placed and the method or methods used in introducing it into the hole. If cement or other plugs were used, state the character of same and depth placed, from \_\_\_\_\_ feet to \_\_\_\_\_ feet for each plug set.

Checked the hole to 3606' and found it open. Filled w/sand to 3575' and dumped 4 sacks of cement. Pulled casing to 600' and circulated pipe with 35 sacks of gel mud and pumped in 20 sacks of cement. Pulled pipe to 180', and pumped in 20 more sacks of cement. Pulled rest of casing, cleared hole and bailed mud to 35', set 10' rock bridge and ran 10 sacks of cement to base of cellar.

PLUGGING COMPLETED

(If additional description is necessary, use BACK of this sheet)

Name of Plugging Contractor West Supply Co., Inc.  
Address Chase, Kansas

10-11-58

STATE OF KANSAS COUNTY OF RICE, ss.  
I, NOEL J. KNIGHT (employee of owner) or (owner or operator) of the above-described well, being first duly sworn on oath, says: That I have knowledge of the facts, statements, and matters herein contained and the log of the above-described well as filed and that the same are true and correct. So help me God.

(Signature) Noel Knight  
Chase, Kansas  
(Address)

SUBSCRIBED AND SWORN TO before me this 3th day of October, 19 58

9-27-52  
lk

Thomas V. Duggins  
Notary Public.

My commission expires \_\_\_\_\_



PLUGGING  
FILE NO. 22 T 9 R 19W  
BOOK PAGE 129 LINE 33

WELL LOG

BARTON #1

Location: NW 1/4, Section 22-98-19W,  
Rooks County, Kansas

OWNER: Sterling Drilling Company, et al.  
ROTARY DRILLING COMPANY: Group Exploration Company  
CABLE TOOL COMPANY: Sterling Drilling Company

COMMENCED: 2-22-55 (w.s.)  
3-1-55 (w.s.t.)  
COMPLETED: 3-4-55 (w.s.)  
3-21-55 (w.s.t.)

ROTARY TOTAL DEPTH: 3592'

LOG

0-60	Clay & Sand	
60-125	Shale & Shells	
125-1255	Shale & Sand	
1255-1500	Red Bed	
1500-1515	Sulphurite	
1515-1675	Shale	
1675-2215	Shale & Shells	
2215-2960	Shale & Limestone	
2960-3100	Shale & Shells	
3100-3170	Limestone & Shale	
3170-3535	Limestone	
3535-3592	Limestone & Shale	T.D.

CASING RECORD

Run 217' of 8-5/8" casing set with  
125 sacks bulk cement and 2 sacks  
calcium chloride.

Set 5-1/2" casing at 3585' with 100  
sacks cement.

CABLE TOOLS N.I.C.T. Washed mud and drilled cement. Drilled new hole from 3592' to  
3606'. Hole filled up with 175' of fluid overnight, 155 gal. oil and 20 gal. rotary mud.  
Acidized with 500 gal. Hole filled with 370' of fluid overnight, 35 gal. water. Acidized  
with 1500 gal. Swab tested at rate of 1/2 bbls. fluid per hour, 45% water. N.O.S.T.

RECEIVED  
STATE CORPORATION COMMISSION

SEP 17 1958

CONSERVATION DIVISION  
Wichita, Kansas

PLUGGING			
FILE	SEC 22	T. 9	R. 19W
BOOK	PAGE 129	LINE	33