

STATE OF KANSAS
STATE CORPORATION COMMISSION


WELL PLUGGING RECORD

Give All Information Completely
Make Required Affidavit
Mail or Deliver Report to:
Conservation Division
State Corporation Commission
800 Biting Building
Wichita, Kansas

OR
FORMATION PLUGGING RECORD

Strike out upper line
when reporting plug-
ging off formations.

Rocks.....County. Sec. 22 Twp. 9s Rge. 19 (E) W (W)
Location as "NE $\frac{1}{4}$ NW $\frac{1}{4}$ SW $\frac{1}{4}$ " or footage from lines. SW SW SE
Lease Owner. Salina Drilling Corp.
Lease Name. Bartos Well No. 2
Office Address. Box 566 Salina Kan.
Character of Well (completed as Oil, Gas or Dry Hole) Dry Hole
Date well completed. 8/5/ ~~3648/6~~ 1952
Application for plugging filed. 8/5/ 1952
Application for plugging approved. 8/5/ 1952
Plugging commenced. 8pm. 8/5/ 1952
Plugging completed. 11 pm. 8/5/ 1952
Reason for abandonment of well or producing formation.....
If a producing well is abandoned, date of last production..... 19.....
Was permission obtained from the Conservation Division or its agents before plugging was com-
menced?.....Yes

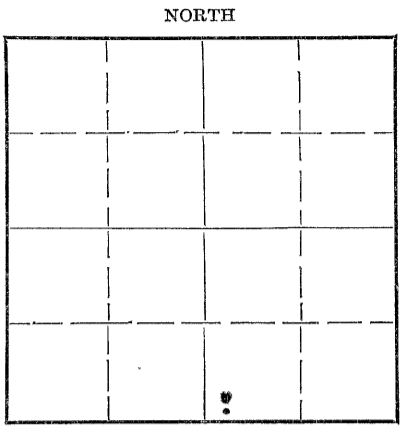

Locate well correctly on above
Section Plat

Name of Conservation Agent who supervised plugging of this well.....
Producing formation. Arb Depth to top. To low Bottom..... Total Depth of Well. 3648 Feet
Show depth and thickness of all water, oil and gas formations.

OIL, GAS OR WATER RECORDS

CASING RECORD

Formation	Content	From	To	Size	Put In	Pulled Out
<u>Didnot find Arb.</u>						
	<u>Surface pipe</u>	<u>0</u>	<u>121</u>	<u>10 3/4</u>		

Describe in detail the manner in which the well was plugged, indicating where the mud fluid was placed and the method or methods used in introducing it into the hole. If cement or other plugs were used, state the character of same and depth placed, from.....feet to.....feet for each plug set.

Wooden plug at 150feet with 20 sacks of cement
plug at 40 feet with 10 sacks of cement

RECEIVED
STATE CORPORATION COMMISSION
SEP 10 1952
9-10-52
CONSERVATION DIVISION
Wichita, Kansas

(If additional description is necessary, use BACK of this form)
Correspondence regarding this well should be addressed to Salina Drilling Corp.
Address. Box 566 Salina Kansas

STATE OF Kansas, COUNTY OF Barton, ss.
H. L. King Drilling, Sup. (employee of owner) or (owner or operator) of the above-described well,
being first duly sworn on oath, says: That I have knowledge of the facts, statements, and matters herein contained and the log of the above-described well as filed and that the same are true and correct. So help me God.

(Signature) H. L. King
Great Bend Kansas
(Address)

SUBSCRIBED AND SWORN to before me this 8 th. day of Sept., 19 52

My commission expires February 6, 1956 Eleanor Tobias Notary Public.

22-2625 2-48-15M
PLUGGING
FILE 227 9 R19
BOOK PAGE 37 LINE 4


15-163-02818-00-00

Salina Drilling Corporation, Inc.,
No. 2 Bartos
C 1/4 SW SE Sec. 22-9S-19W
Zurich Townsite Pool
Rooks County, Kansas

Elevation: 2187 Rotary Bushing
2184 Derrick Floor
Spud 7-26-52: 10 3/4" csg 120'
Completed 8-5-52
Plugged and abandoned

Topeka	3173
Heebner Shale	3346
Toronto	3367
Lansing-Kansas City	3388
Top Marmaton	3600
Rotary Total Depth	3648

Plugged and abandoned

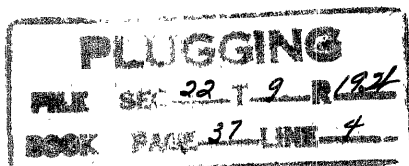

