


STATE OF KANSAS
STATE CORPORATION COMMISSION

WELL PLUGGING RECORD

Give All Information Completely
Make Required Affidavit
Mail or Deliver Report to:
Conservation Division
State Corporation Commission
800 Bittling Building
Wichita, Kansas

Rooks County. Sec. 22 Twp. 9 Rge. 19 (E) (W)
Location as "NE/CNW/SW" or footage from lines SE NE SE
Lease Owner Sterling Drilling Company, et al
Lease Name Bartos "B" Well No. 2
Office Address Sterling, Kansas
Character of Well (completed as Oil, Gas or Dry Hole) Dry Hole
Date well completed February 23, 1956
Application for plugging filed February 23, 1956
Application for plugging approved February 23, 1956
Plugging commenced February 23, 1956
Plugging completed February 23, 1956
Reason for abandonment of well or producing formation

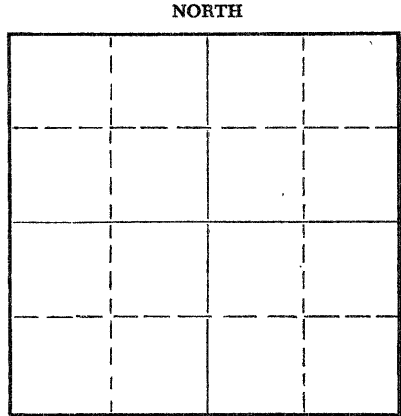

Locate well correctly on above
Section Plat

If a producing well is abandoned, date of last production 19
Was permission obtained from the Conservation Division or its agents before plugging was commenced? Yes

Name of Conservation Agent who supervised plugging of this well Eldon Petty
Producing formation Depth to top Bottom Total Depth of Well 3630 Feet
Show depth and thickness of all water, oil and gas formations.

OIL, GAS OR WATER RECORDS

CASING RECORD

FORMATION	CONTENT	FROM	TO	SIZE	PUT IN	PULLED OUT
				8-5/8"	236'	

Describe in detail the manner in which the well was plugged, indicating where the mud fluid was placed and the method or methods used in introducing it into the hole. If cement or other plugs were used, state the character of same and depth placed, from feet to feet for each plug set.

Filled hole with heavy mud. Set bottom plug at 228'. Filled hole to 40' and set top plug with 10 sacks cement on top.

(If additional description is necessary, use BACK of this sheet)

Name of Plugging Contractor Sterling Drilling Company
Address Sterling, Kansas


STATE OF KANSAS, COUNTY OF RICE, ss.
F. A. Wuellner (employee of owner) or (owner or operator) of the above-described well, being first duly sworn on oath, says: That I have knowledge of the facts, statements, and matters herein contained and the log of the above-described well as filed and that the same are true and correct. So help me God.

(Signature) *F. A. Wuellner*
Sterling, Kansas
(Address)

SUBSCRIBED AND SWORN TO before me this 27th day of February, 1956

Bernard Laufermilk
Notary Public.

My commission expires Jan. 22, 1958

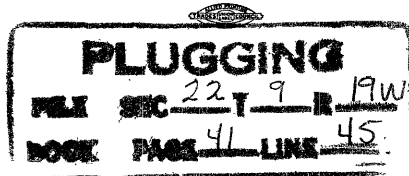

2-29-56

STERLING DRILLING COMPANY
Sterling, Kansas

WELL LOG-----EARTHS "B" #2

Location: SE NE SE, Section 22-9S-19W,
Rooks County, Kansas

OWNER: Sterling Drilling Company, et al
ROTARY DRILLING CONTRACTOR: Sterling Drilling Company

COMMENCED: 2-15-56 (w.r.)
COMPLETED: 2-23-56 (w.r.)

TOTAL DEPTH: 3630'.

LOG

CASING RECORD

0-210	Sand & Shale	
210-975	Shale	
975-1220	Sand & Shale	
1220-1510	Shale	
1510-1550	Anhydrite	
1550-1990	Shale	
1990-2115	Shale & Limestone	
2115-2295	Shale & Shells	
2295-2720	Shale & Limestone	
2720-2805	Limestone	
2805-2950	Shale & Limestone	
2950-3150	Shale	
3150-3240	Shale & Limestone	
3240-3583	Limestone	
3585-3630	Conglomerate	T.D.

Ran 236' of 3-5/8" casing set with
135 sacks cement and 2 sacks calcium
chloride.

PRODUCTION

Plugged & Abandoned

