


STATE OF KANSAS
STATE CORPORATION COMMISSION

Give All Information Completely
Make Required Affidavit
Mail or Deliver Report to:
Conservation Division
State Corporation Commission
800 Bittling Building
Wichita, Kansas

WELL PLUGGING RECORD

NORTH

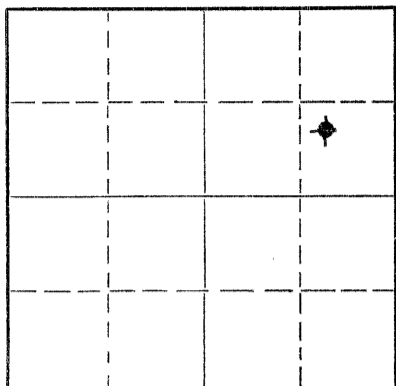

Locate well correctly on above
Section Plat

Rooks County. Sec. 22 Twp. 9S Rge. xxx19 (W)
Location as "NE/CNW/SW" or footage from lines NW/4 SE/4 NE/4
Lease Owner Heathman & Co., Inc.
Lease Name J. BARTOS Well No. 1
Office Address 25 1/2 No. Washington, Wichita 7, Kansas
Character of Well (completed as Oil, Gas or Dry Hole) dry hole
Date well completed 7-13 19 52
Application for plugging filed (verbal) 7-13 19 52
Application for plugging approved (") 7-13 19 52
Plugging commenced _____ 19 _____
Plugging completed _____ 19 _____
Reason for abandonment of well or producing formation _____

If a producing well is abandoned, date of last production _____ 19 _____
Was permission obtained from the Conservation Division or its agents before plugging was commenced? yes

Name of Conservation Agent who supervised plugging of this well Eldon Petty, Hays, Kansas
Producing formation _____ Depth to top _____ Bottom _____ Total Depth of Well 3639 Feet
Show depth and thickness of all water, oil and gas formations.

OIL, GAS OR WATER RECORDS

CASING RECORD

FORMATION	CONTENT	FROM	TO	SIZE	PUT IN	PULLED OUT
<u>Arbuckle</u>	<u>water</u>	<u>3593</u>	<u>3639</u>			
				<u>8-5/8" surf. csg.</u>	<u>162' w/115 sacks</u>	
				<u>cement</u>	<u>- - - - -</u>	<u>none pulled</u>
				<u>5-1/2" oil</u>	<u>string 3598' w/100 sacks</u>	
				<u>cement</u>	<u>- - - - -</u>	

Describe in detail the manner in which the well was plugged, indicating where the mud fluid was placed and the method or methods used in introducing it into the hole. If cement or other plugs were used, state the character of same and depth placed, from _____ feet to _____ feet for each plug set.

Work started July 17, 1952.
Filled hole with crushed rock from total depth 3639' to 3594'
Dumped 5 sacks cement. Shot pipe off at 2985'..Pulled out casing
Filled hole with heavy mud to 157' Set permanent rock bridge
Dumped 15 sacks cement to fill hole to 30' Mixed 10 sacks
cement for cap on well.
Work completed July 24, 1952

8-9-52
CLON

(If additional description is necessary, use BACK of this sheet)

Name of Plugging Contractor Forbes Casing Pulling Co.
Address P. O. Box 221, Great Bend, Kansas


STATE OF Kansas, COUNTY OF Barton, ss.
J. O. Forbes (employee of owner) of the above-described

well, being first duly sworn on oath, says: That I have knowledge of the facts, statements, and matters herein contained and the log of the above-described well as filed and that the same are true and correct. So help me God.

By: J. O. Forbes
(Signature) FORBES CASING PULLING CO.
P.O. Box 221, Great Bend, Kansas
(Address)

SUBSCRIBED AND SWORN to before me this 7 day of August, 19 52

My commission expires February 4, 1956 Travis Wankle Notary Public.

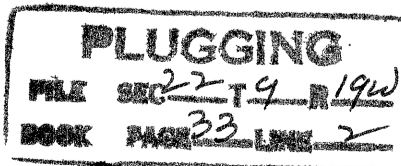

J. BARTOS #1

copy

Location: NW SE NE Sec. 22-98-19W
Rocks County, Kansas

Operator: Heathman & Co., Inc.

Contractor: Walters Drilling Co., Inc.

Surface Casing: 8 5/8" set at 162' with
115 sacks cement and 1 sack
Cal. Chloride

Oil String: 5 1/2" set at 3598' with
100 sacks cement.

Date Spudded: June 17, 1952

Rotary Completion: June 27, 1952

Elevations: 2165 Gr
2167 DF
2169 KB

LOG

(Figures indicate bottom of formation)

Surface	0 to 162
Shale, limestone and Sand	465
Shale and Lime	900
Sand and Shale	1035
Sand	1270
Shale	1535
Anhydrite	1570
Shale, Shells and Lime	1843
Shale and Shells	2000
Shale, Shells and Lime	2200
Lime and Shale Shells	2335
Lime and Shale	3598
Total Depth (Rotary)	3598

The undersigned, Robert F. Walters, hereby certifies that the above log is a true and correct log of the formations encountered in drilling the above noted well as reflected by the Daily Drilling Reports.

WALTERS DRILLING CO., INC.

By Robert F. Walters

Subscribed and sworn to before me
this 3rd day of July, 1952.

Pauline Henderson
Notary Public

My commission expires March 10, 1956.

