


STATE OF KANSAS  
STATE CORPORATION COMMISSION

Give All Information Completely  
Make Required Affidavit  
Mail or Deliver Report to:  
Conservation Division  
State Corporation Commission  
212 North Market, Insurance Bldg.  
Wichita, Kansas

**WELL PLUGGING RECORD**

NORTH

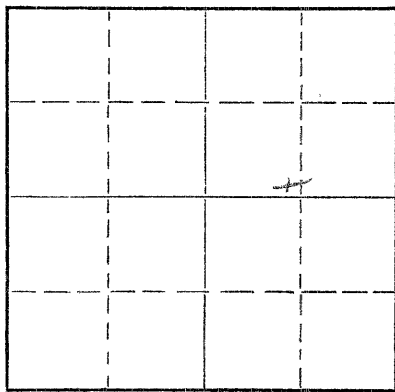

Locate well correctly on above  
Section Plat

Rooks County. Sec. 22 Twp. 9 Rge. 19W (E) (W)  
Location as "NE/CNW/SW" or footage from lines. SE SW NE  
Lease Owner Louie B. Lawrence  
Lease Name Bartos "A" Well No. 2  
Office Address Box 448, Great Bend, Kansas  
Character of Well (completed as Oil, Gas or Dry Hole) oil  
Date well completed \_\_\_\_\_ 19\_\_\_\_  
Application for plugging filed October 12, 1959 19\_\_\_\_  
Application for plugging approved October 13, 1959 19\_\_\_\_  
Plugging commenced July 7, 1959 19\_\_\_\_  
Plugging completed October 12, 1959 19\_\_\_\_  
Reason for abandonment of well or producing formation dry

If a producing well is abandoned, date of last production \_\_\_\_\_ 19\_\_\_\_  
Was permission obtained from the Conservation Division or its agents before plugging was commenced? yes

Name of Conservation Agent who supervised plugging of this well Eldon Petty  
Producing formation \_\_\_\_\_ Depth to top \_\_\_\_\_ Bottom \_\_\_\_\_ Total Depth of Well 3612 Feet  
Show depth and thickness of all water, oil and gas formations.

**OIL, GAS OR WATER RECORDS**

**CASING RECORD**

FORMATION	CONTENT	FROM	TO	SIZE	PUT IN	PULLED OUT

Describe in detail the manner in which the well was plugged, indicating where the mud fluid was placed and the method or methods used in introducing it into the hole. If cement or other plugs were used, state the character of same and depth placed, from \_\_\_\_\_ feet to \_\_\_\_\_ feet for each plug set.

Sand to 3580' mix and dump 5 sacks cement  
circulate hole with 35 sacks jell mud @500'  
pump 20 sacks cementmud to 150' with 20 sacks cement  
mud to 40' rock bridge with 10 sacks cement.

**RECEIVED**  
STATE CORPORATION COMMISSION

OCT 19 1959  
10-19-59  
CONSERVATION DIVISION  
Wichita, Kansas

(If additional description is necessary, use BACK of this sheet)

Name of Plugging Contractor Southwest Casing Pulling Co., Inc.  
Address Box 364, Great Bend, Kansas

STATE OF Kansas, COUNTY OF Barton, ss.  
Southwest Casing Pulling Co., Inc. (employee of owner) or (owner or operator) of the above-described well, being first duly sworn on oath, says: That I have knowledge of the facts, statements, and matters herein contained and the log of the above-described well as filed and that the same are true and correct. So help me God.

(Signature) Roy L. Myers Roy L. Myers Sec. Treas.  
Box 364, Great Bend, Kansas  
(Address)

SUBSCRIBED AND SWORN TO before me this 16 day of October, 1959

My commission expires December 18, 1962 Juanita R. Myers Notary Public.

