


WELL PLUGGING RECORD

Give All Information Completely
Make Required Affidavit
Mail or Deliver Report to:
Conservation Division
State Corporation Commission
211 No. Broadway
Wichita, Kansas

Rooks County. Sec. 22 Twp. 9S Rge. 19 (E) 19 (W)

Location as "NE/CNW/SW" or footage from lines NE NE SW
Lease Owner Petroleum Operating Company
Lease Name Desmarteau Well No. 1
Office Address Box 7027, Tulsa, Oklahoma
Character of Well (completed as Oil, Gas or Dry Hole) Dry Hole
Date well completed 6-26 19 62
Application for plugging filed 6-26 19 62
Application for plugging approved 6-26 19 62
Plugging commenced 6-26 19 62
Plugging completed 6-26 19 62
Reason for abandonment of well or producing formation Dry Hole

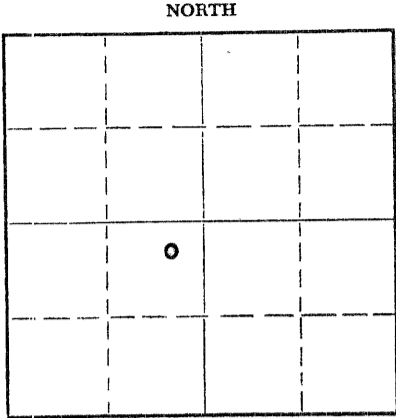

Locate well correctly on above Section Plat

If a producing well is abandoned, date of last production _____ 19____
Was permission obtained from the Conservation Division or its agents before plugging was commenced? Yes

Name of Conservation Agent who supervised plugging of this well Eldon Petty
Producing formation Dry Hole Depth to top _____ Bottom _____ Total Depth of Well 3638 Feet
Show depth and thickness of all water, oil and gas formations.

OIL, GAS OR WATER RECORDS

CASING RECORD

FORMATION	CONTENT	FROM	TO	SIZE	PUT IN	PULLED OUT
<u>Lansing</u>	<u>mud</u>	<u>3371</u>	<u>3587</u>	<u>8-5/8"</u>	<u>176'</u>	<u>none</u>
<u>Arbuckle</u>	<u>water</u>	<u>3616</u>	<u>T.D.</u>			

Describe in detail the manner in which the well was plugged, indicating where the mud fluid was placed and the method or methods used in introducing it into the hole. If cement or other plugs were used, state the character of same and depth placed, from _____ feet to _____ feet for each plug set.

Bottom plug @ 550' w/20 cement
Middle plug @ 170' w/20 cement
Top plug @ 35' w/10 cement & 1/2 sk hulls

(If additional description is necessary, use BACK of this sheet)
Name of Plugging Contractor Rotary well drilled - no pipe set.
Address _____

STATE OF OKLAHOMA, COUNTY OF _____, ss.
Joseph Teichman (employee of owner) or (owner or operator) of the above-described well, being first duly sworn on oath, says: That I have knowledge of the facts, statements, and matters herein contained and the log of the above-described well as filed and that the same are true and correct. So help me God.

(Signature) Joseph Teichman
(Address) _____

SUBSCRIBED AND SWORN TO before me this 2nd day of July, 19 62

My commission expires 3-17-64 _____ Notary Public.



SHOLOM DRILLING COMPANY, INC.
P. O. Box 7027
Tulsa, Oklahoma

FORMATION LOG

COMPANY: Petroleum Operating Company
FARM: Desmarteau #1
LOCATION: NE NE SW Section 22 T9S R19W - Rooks County, Kansas
ROTARY DRILLING CONTRACTOR: Sholom Drilling Company, Inc.

COMMENCED: 6-17-62
COMPLETED: 6-26-62
I. P.: D & A

Elevation: 2178' K.B.
Rotary TD: 3638'

Casing Record:
8-5/8" @ 176' w/135 sax

LOG

0 -	10	Clay
10 -	25	Sand
25 -	157	Shale
157 -	176	Plug & Cement
176 -	325	Shale & Sand Streaks
325 -	550	Shale
550 -	660	Shale & Sand
660 -	700	Sand
700 -	720	Sand & Shale
720 -	1000	Shale & Sand Streaks
1000 -	1050	Shale & Sand
1050 -	1280	Sand
1280 -	1300	Sand & Shale
1300 -	1546	Red Bed
1546 -	1586	Anhydrite
1586 -	2100	Shale & Shells
2100 -	3094	Lime & Shale
3094 -	3590	Lime
3590 -	3600	Shale
3600 -	3616	Cong.
3616 -	3638	Arbuckle

DST #1	3374-3434
Rec.	10' mud
DST #2	3490-3590
Rec.	12' mud
DST #3	3617-25 (misrun)
DST #3	3617-25
Rec.	10' mud
DST #4	3622-38
Rec.	10' mud
Anhydrite	1546-86
Topeka	3150
Heebner	3329
Toronto	3348
Lansing	3371
Base K.C.	3587
Marmaton	3596
Conglomerate	3605
Arbuckle	3616

STATE OF OKLAHOMA)

COUNTY OF TULSA)

I, Joseph Telchman, President of Sholom Drilling Company, Inc. a corporation of the State of Oklahoma, domesticated in the State of Kansas, being first duly sworn under oath, says: That I have knowledge of the facts, statements and matters herein contained of the above described well as filed and that the same are true and correct.

Joseph Telchman

Joseph Telchman

Subscribed and sworn to before me this 2nd day of July, 1962.

Vernie Hunter

Notary Public

My commission expires: 3-17-64