


STATE OF KANSAS
STATE CORPORATION COMMISSION

WELL PLUGGING RECORD

Give All Information Completely
Make Required Affidavit
Mail or Deliver Report to
Conservation Division
State Corporation Comm.
245 North Water
Wichita, KS 67202

Graham County, Sec. 13 Twp. 9 Rge. 21 NE/W
Location as "NE/CNW $\frac{1}{4}$ /SW $\frac{1}{4}$ " or footage from lines

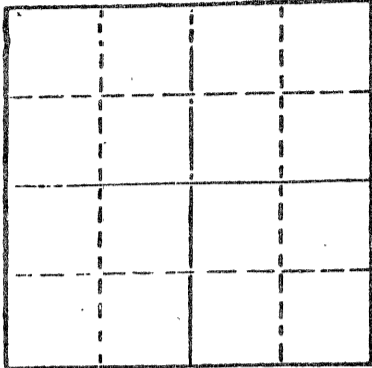

Locate well correctly on above
Section Plot

NE NW SE
Lease Owner J. B. Collins
Lease Name Balthazor Well No. 6
Office Address 1007 Cody - Suite A, Hays, KS 67601
Character of Well (Completed as Oil, Gas or Dry Hole) Dry Hole
Date Well completed 1-19 1978
Application for plugging filed 1-19 1978
Application for plugging approved 1-19 1978
Plugging commenced 1-19 1978
Plugging completed 1-19 - 1978
Reason for abandonment of well or producing formation Dry Hole

If a producing well is abandoned, date of last production 19

Was permission obtained from the Conservation Division or its agents before plugging was commenced? yes

Name of Conservation Agent who supervised plugging of this well Gilbert Balthazor
Producing formation Depth to top Bottom Total Depth of Well 3,742'
Show depth and thickness of all water, oil and gas formations.

OIL, GAS OR WATER RECORDS

CASING RECORD

FORMATION	CONTENT	FROM	TO	SIZE	PUT IN	PULLED OUT
Surface Pipe				8 5/8"	167'	0'

Describe in detail the manner in which the well was plugged, indicating where the mud fluid was placed and the method or methods used in introducing it into the hold. If cement or other plugs were used, state the character of same and depth placed, from feet to feet for each plug set.

- 1st plug was set @ 750' w/70 sacks cement
- 2nd plug was set @ 160' w/20 sacks cement
- 3rd plug was set @ 40' w/10 sacks cement

RECEIVED
STATE CORPORATION COMMISSION
JAN 27 1978
1-27-78
CONSERVATION DIVISION
Wichita, Kansas

(If additional description is necessary, use BACK of this sheet)

Name of Plugging Contractor Drilling Oil, Inc.

STATE OF KANSAS COUNTY OF ELLIS, ss.

I, Joseph A. Hess, Sec. Rreas. of Drg. Contractor (employee of owner) or (owner or operator) of the above-described well, being first duly sworn on oath, says: That I have knowledge of the facts, statements, and matters herein contained and the log of the above-described well as filed and that the same are true and correct. So help me God.

(Signature)

JOSEPH A. HESS

(Address)

SUBSCRIBED AND SWORN TO before me this 26 day of January, 1978

Cecilia Basgall
Cecilia Basgall Notary Public.

My commission expires November 17, 1980

CECILIA BASGALL
NOTARY PUBLIC
Ellis County, Kansas

DREILING OIL, INC.

Victoria, Kansas 67671

J. B. Collins
1007 Cody - Suite A
Hays, KS 67601

WELL LOG

Company: J. B. Collins
Farm: Balthazor No. 6
Total Depth: 3,742'
Comm.: 1-12-78 Comp.: 1-19-78
Contractor: Dreiling Oil, Inc.
Rt. #1
Victoria, KS 67671

Sec. 13 Twp. 9 Rng. 21
Location: NE NW SE
County: Graham
Elevation: 2208 K. B.
2205 D. F.
2203 G. R.

Casing Record
167' - 8 5/8"

Cement Record
135 sacks cement

Production:
D & A

Figures Indicate Bottom of Formations

0'	125'	Sand
125'	1200'	Shale
1200'	1372'	Sand
1372'	1433'	Shale
1433'	1689'	Shale & Red Bed
1689'	1731'	Anhydrite
1731'	2626'	Shale
2626'	3296'	Shale & Lime
3296'	3742'	Lime
3742'	T.D.	

RECEIVED
STATE CORPORATION COMMISSION

JAN 27 1978

STATE OF KANSAS)
) ss
COUNTY OF ELLIS)

CONSERVATION DIVISION
Wichita, Kansas

I, Joseph A. Hess, Secretary Treasurer of Dreiling Oil, Inc., upon oath states that the above and foregoing is a true and correct copy from the Daily Drilling Report from the Balthazor #6.


JOSEPH A. HESS

Subscribed and sworn to before me this 26th day of January, 1978.


Cecilia Basgall Notary Public

CECILIA BASGALL
NOTARY PUBLIC
Ellis County, Kansas

My appointment expires: November 17, 1980.