

KCC Use: Effective Date:
 Effective Date: 7-18-07
 District # 3
 Yes No

KANSAS CORPORATION COMMISSION
 OIL & GAS CONSERVATION DIVISION

Form C-1
 December 2002
 Form must be Typed
 Form must be Signed
 All blanks must be Filled

NOTICE OF INTENT TO DRILL

Must be approved by KCC five (5) days prior to commencing well

Expected Spud Date 7/16/07
 month day year

OPERATOR: License# 33740
 Name: Hemi Energy Group, Inc.
 Address: 131 East Exchange Ave #223
 City/State/Zip: Ft. Worth, TX 76106
 Contact Person: Craig Treiber
 Phone: 918-607-8505

CONTRACTOR: License# 5495 5675 per operator
 Name: McPherson Drilling

Well Drilled For: Oil Gas OGW Seismic Other
 Enth Rec Storage Disposal # of Holes _____
 Well Class: Infield Pool Ext. Wildcat Other
 Type Equipment: Mud Rotary Air Rotary Cable

OLD WELL INFORMATION AS FOLLOWS:
 Operator: _____
 Well Name: _____
 Original Completion Date: _____ Original Total Depth: _____
 Directional, Deviated or Horizontal wellbore? Yes No
 Yes, true vertical depth: _____
 Bottom Hole Location: _____
 KCC DKT #: _____

Spot NE NE NE
 Sec. 29 Twp. 25 S. R. 17
 East West
165 feet from N / S Line of Section
165 feet from E / W Line of Section
 Is SECTION Regular Irregular?

(Note: Locate well on the Section Plat on reverse side)
 County: Woodson
 Lease Name: Tebbens Well #: Hemi 1
 Field Name: Humboldt Chanute
 Is this a Prorated / Spaced Field? Yes No
 Target Formation(s): Arbuckle
 Nearest Lease or unit boundary: 165' FNL feet MSL
 Ground Surface Elevation: 998 feet MSL
 Water well within one-quarter mile: Yes No
 Public water supply well within one mile: Yes No
 Depth to bottom of fresh water: 100'
 Depth to bottom of usable water: 200'
 Surface Pipe by Alternate: 1 2
 Length of Surface Pipe Planned to be set: 42'
 Length of Conductor Pipe required: NR
 Projected Total Depth: 1,700'
 Formation at Total Depth: Arbuckle
 Water Source for Drilling Operations:
 Well Farm Pond Other Municipal
 DWR Permit #: _____
 (Note: Apply for Permit with DWR)
 Will Cores be taken? Yes No
 If Yes, proposed zone: _____

AFFIDAVIT

RECEIVED
 KANSAS CORPORATION COMMISSION

JUL 12 2007

I, the undersigned hereby affirms that the drilling, completion and eventual plugging of this well will comply with K.S.A. 55 et. seq.
 I have agreed that the following minimum requirements will be met:
 1. Notify the appropriate district office prior to spudding of well;
 2. A copy of the approved notice of intent to drill shall be posted on each drilling rig;
 3. The minimum amount of surface pipe as specified below shall be set by circulating cement to the top; in all cases surface pipe shall be set through all unconsolidated materials plus a minimum of 20 feet into the underlying formation.
 4. If the well is dry hole, an agreement between the operator and the district office on plug length and placement is necessary prior to plugging;
 5. The appropriate district office will be notified before well is either plugged or production casing is cemented in;
 6. If an ALTERNATE II COMPLETION, production pipe shall be cemented from below any usable water to surface within 120 days of spud date.
 Or pursuant to Appendix "B" - Eastern Kansas surface casing order #133,891-C, which applies to the KCC District 3 area, alternate II cementing must be completed within 30 days of the spud date or the well shall be plugged. In all cases, NOTIFY district office prior to any cementing.
 I hereby certify that the statements made herein are true and to the best of my knowledge and belief.

Date: July 10, 2007 Signature of Operator or Agent: Craig Treiber Title: COO/VP

For KCC Use ONLY
 API # 15 - 207-27200-0000
 Conductor pipe required None feet
 Minimum surface pipe required 20 feet per Alt. XO 2
 Approved by: 7-13-07
 This authorization expires: 1-13-08
 (This authorization void if drilling not started within 6 months of effective date.)
 Spud date: _____ Agent: _____

Remember to:
 - File Drill Pit Application (form CDP-1) with Intent to Drill;
 - File Completion Form ACO-1 within 120 days of spud date;
 - File acreage attribution plat according to field proration orders;
 - Notify appropriate district office 48 hours prior to workover or re-entry;
 - Submit plugging report (CP-4) after plugging is completed;
 - Obtain written approval before disposing or injecting salt water.
 - If this permit has expired (See: authorized expiration date) please check the box below and return to the address below.
 Well Not Drilled - Permit Expired
 Signature of Operator or Agent: _____
 Date: _____

29 25 17E

IN ALL CASES PLOT THE INTENDED WELL ON THE PLAT BELOW

Plat of acreage attributable to a well in a prorated or spaced field

If the intended well is in a prorated or spaced field, please fully complete this side of the form. If the intended well is in a prorated or spaced field complete the plat below showing that the well will be properly located in relationship to other wells producing from the common source of supply. Please show all the wells and within 1 mile of the boundaries of the proposed acreage attribution unit for gas wells and within 1/2 mile of the boundaries of the proposed acreage attribution unit for oil wells.

API No. 15 - _____
Operator: Hemi Energy Group, Inc.
Lease: Tebbens
Well Number: Hemi 1
Field: Humbolt Chanute
Number of Acres attributable to well: _____
QTR / QTR / QTR of acreage: NE NE - NE NE


Location of Well: County: Woodson
145 165 CL feet from N / S Line of Section
150 165 CL feet from E / W Line of Section
Sec. 29 Twp. 25 S. R. 17 East West
Is Section: Regular or Irregular
If Section is irregular, locate well from nearest corner boundary.
Section corner used: NE NW SE SW

~~NOTE: Distances to lease lines under 165' to miss known "junk pile" and existing lease pipeline and still stay above known high water line.~~


PLAT

*(Show location of the well and shade attributable acreage for prorated or spaced wells.)
(Show footage to the nearest lease or unit boundary line.)*

Loc changed to 165' per operator 7-12-07

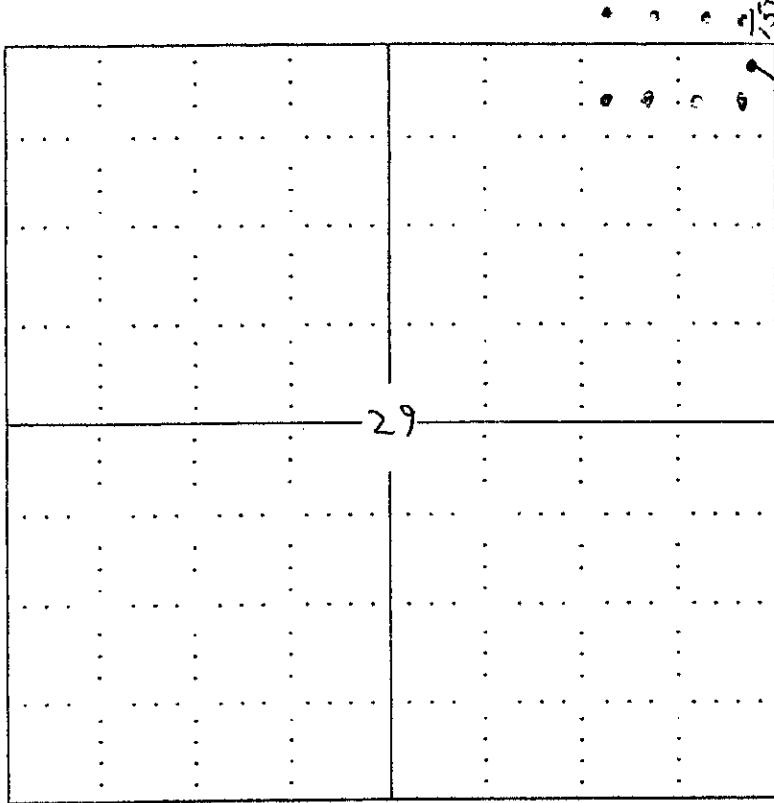

145 Both 165' CL Hemi #1

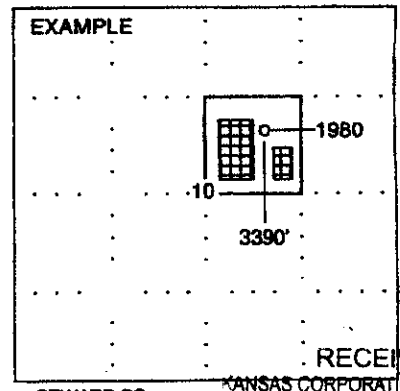

RECEIVED
SEWARD CO. KANSAS CORPORATION COMMISSION

JUL 12 2007

CONSERVATION DIVISION
WICHITA, KS

NOTE: In all cases locate the spot of the proposed drilling location.

Woodson County


In plotting the proposed location of the well, you must show:

1. The manner in which you are using the depicted plat by identifying section lines, i.e. 1 section, 1 section with 8 surrounding sections, 4 sections, etc.
2. The distance of the proposed drilling location from the section's south / north and east / west.
3. The distance to the nearest lease or unit boundary line.
4. If proposed location is located within a prorated or spaced field a certificate of acreage attribution plat must be attached: (CO-7 for oil wells;

**KANSAS CORPORATION COMMISSION
OIL & GAS CONSERVATION DIVISION
APPLICATION FOR SURFACE PIT**

Form CDP-1
April 2004
Form must be Typed

Submit in Duplicate

Operator Name: <u>Hemi Energy Group, Inc.</u>		License Number: <u>33740</u>
Operator Address: <u>131 East Exchange Ave. #223, Ft. Worth, TX 76106</u>		
Contact Person: <u>Craig Treiber</u>		Phone Number: <u>(918) 607-8505</u>
Lease Name & Well No.: <u>Tebbens Hemi 1</u>		Pit Location (QQQQ): <u>NE - NE - NE - NE</u>
Type of Pit: <input type="checkbox"/> Emergency Pit <input type="checkbox"/> Burn Pit <input type="checkbox"/> Settling Pit <input checked="" type="checkbox"/> Drilling Pit <input type="checkbox"/> Workover Pit <input type="checkbox"/> Haul-Off Pit <small>(If WP Supply API No. or Year Drilled)</small>	Pit is: <input checked="" type="checkbox"/> Proposed <input type="checkbox"/> Existing If Existing, date constructed: _____ Pit capacity: <u>800 BBL +/-</u> (bbls)	Sec. <u>29</u> Twp. <u>25</u> R. <u>17</u> <input checked="" type="checkbox"/> East <input type="checkbox"/> West <u>175</u> ^{CV} Feet from <input checked="" type="checkbox"/> North / <input type="checkbox"/> South Line of Section <u>176</u> ^{CV} Feet from <input checked="" type="checkbox"/> East / <input type="checkbox"/> West Line of Section <u>Woodson</u> County
Is the pit located in a Sensitive Ground Water Area? <input type="checkbox"/> Yes <input checked="" type="checkbox"/> No		Chloride concentration: _____ mg/l <small>(For Emergency Pits and Settling Pits only)</small>
Is the bottom below ground level? <input type="checkbox"/> Yes <input type="checkbox"/> No	Artificial Liner? <input type="checkbox"/> Yes <input checked="" type="checkbox"/> No	How is the pit lined if a plastic liner is not used? <u>Air Drilling pit, no liner</u>
Pit dimensions (all but working pits): <u>40</u> Length (feet) <u>16</u> Width (feet) _____ N/A: Steel Pits Depth from ground level to deepest point: <u>8</u> (feet)		
If the pit is lined give a brief description of the liner material, thickness and installation procedure. <u>NA</u>		Describe procedures for periodic maintenance and determining liner integrity, including any special monitoring. <u>Visual Inspection</u>
Distance to nearest water well within one-mile of pit <u>3537</u> ⁸⁰ NA feet Depth of water well <u>200 +/-</u> feet		Depth to shallowest fresh water <u>100 +/-</u> feet. <u>28</u> JR-KGS Source of information: <u>Per KCC API 207 27112 0000</u> _____ measured _____ well owner _____ electric log _____ KDWR
Emergency, Settling and Burn Pits ONLY: Producing Formation: <u>NA</u> Number of producing wells on lease: _____ Barrels of fluid produced daily: _____ Does the slope from the tank battery allow all spilled fluids to flow into the pit? <input type="checkbox"/> Yes <input type="checkbox"/> No		Drilling, Workover and Haul-Off Pits ONLY: Type of material utilized in drilling/workover: <u>Water, cement</u> Number of working pits to be utilized: <u>1</u> Abandonment procedure: <u>Fill with dozed dirt</u> Drill pits must be closed within 365 days of spud date.
I hereby certify that the above statements are true and correct to the best of my knowledge and belief.		
<u>7/11/07</u> Date	 Signature of Applicant or Agent	RECEIVED JUL 12 2007 KANSAS CORPORATION COMMISSION CONSERVATION DIVISION WICHITA, KS

KCC OFFICE USE ONLY

Date Received: 7/12/07 Permit Number: _____ Permit Date: 7/12/07 Lease Inspection: Yes No