

CARD MUST BE TYPED

State of Kansas
NOTICE OF INTENTION TO DRILL
(see rules on reverse side)

CARD MUST BE SIGNED

Starting Date: December 29, 1984
month day year

API Number 15- 125-27,537-00-00

OPERATOR: License # 4093
Name Jesse Butcher
Address Box 57
City/State/Zip South Coffeyville, Okla 74072
Contact Person Jesse Butcher
Phone 918 255 6480

APP SW · NW · SW · Sec .12 · Twp .35 · S, Rge .16 · East
(location) West

1450 Ft North from Southeast Corner of Section
4920 Ft West from Southeast Corner of Section
(Note: Locate well on Section Plat on reverse side)

CONTRACTOR: License # 6501
Name Ted King Drilling
City/State Wann, Okla. 74083

Nearest lease or unit boundary line 165 feet.
County Montgomery
Lease Name Butcher Well# 2

Well Drilled For: Well Class: Type Equipment:
 Oil Swd Infield Mud Rotary
 Gas Inj Pool Ext. Air Rotary
 OWWO Expl Wildcat Cable

Domestic well within 330 feet: yes no
Municipal well within one mile: yes no

If OWWO: old well info as follows:
Operator
Well Name
Comp Date Old Total Depth
Projected Total Depth 800 feet
Projected Formation at TD
Expected Producing Formations

Depth to Bottom of fresh water 30 feet
Lowest usable water formation
Depth to Bottom of usable water 150 feet
Surface pipe by Alternate: 1 2
Surface pipe to be set 40 feet
Conductor pipe if any required feet
Ground surface elevation feet MSL
This Authorization Expires 6-28-85
Approved By RCM/KCC 12-28-84

I certify that we will comply with K.S.A. 55-101, et seq., plus eventually plugging hole to K.C.C. specifications.

Date 12-26/84 Signature of Operator or Agent Jesse Butcher


Title Operator

MHC/KOHE 12/29/84 Form C-1 4/84

Must be filed with the K.C.C. five (5) days prior to commencing well
This card void if drilling not started within six (6) months of date received by K.C.C.

Important procedures to follow :

**A Regular Section of Land
1 Mile = 5,280 Ft.**

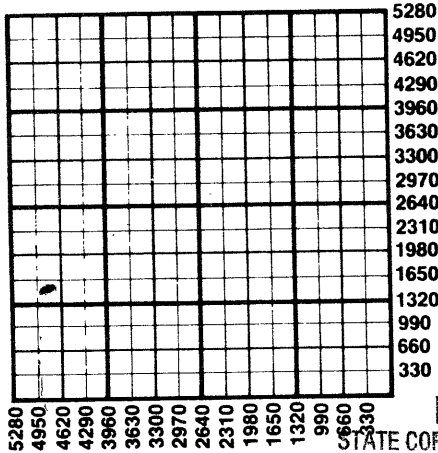

1. Notify District office before setting surface casing.
2. Set surface casing by circulating cement to the top.
3. File completion forms ACO-1 with K.C.C. within 90 days of well completion, following instructions on ACO-1, side 1, and including copies of wireline logs.
4. Notify District office 48 hours prior to old well workover or re-entry.
5. Prior to plugging, prepare a plugging plan, then obtain agreement from the appropriate district office for an approved plugging plan.
6. Submit plugging report (CP-4) to K.C.C. after plugging is completed.
7. Obtain an approved injection docket number before disposing of salt water.
8. Notify K.C.C. within 10 days when injection commences or terminates.
9. If an alternate 2 completion, cement in the production pipe from below any usable water to surface within 120 days of spud date.

RECEIVED

STATE CORPORATION COMMISSION

State Corporation Commission of Kansas
Conservation Division

200 Colorado Derby Building

Wichita, Kansas 67202

(316) 263-3238

DEC 28 1984

CONSERVATION DIVISION
Wichita, Kansas

12-28-84