

CARD MUST BE TYPED

State of Kansas
NOTICE OF INTENTION TO DRILL
 (see rules on reverse side)

CARD MUST BE SIGNED

Starting Date: Aug. 4 1985
 month day year

OPERATOR: License # 4093
 Name Jesse Butcher
 Address Box 57
 City/State/Zip South Coffeyville, Ok. 74072
 Contact Person Jesse Butcher
 Phone 918.255.6480

CONTRACTOR: License # 6501
 Name Ted King Drilling
 City/State Wann, Ok. 74083

Well Drilled For:	Well Class:	Type Equipment:
<input checked="" type="checkbox"/> Oil <input type="checkbox"/> Swd <input type="checkbox"/> Infield <input checked="" type="checkbox"/> Mud Rotary		
<input type="checkbox"/> Gas <input type="checkbox"/> Inj <input type="checkbox"/> Pool Ext. <input type="checkbox"/> Air Rotary		
<input type="checkbox"/> OWWO <input type="checkbox"/> Expl <input checked="" type="checkbox"/> Wildcat <input type="checkbox"/> Cable		

If OWWO: old well info as follows:

Operator

Well Name

Comp Date Old Total Depth

Projected Total Depth 800 feet

Projected Formation at TD

Expected Producing Formations

I certify that we will comply with K.S.A. 55-101, et seq., plus eventually plugging hole to K.C.C. specifications.

Date 7-2-85 Signature of Operator or Agent

API Number 15- 125-27,933-0000
~~SW~~ NW SW Sec 12. Twp 35. S, Rge 16. ☒ East ☐ West
 (location)

..1050..... Ft North from Southeast Corner of Section
 ..4920..... Ft West from Southeast Corner of Section
 (Note: Locate well on Section Plat on reverse side)

Nearest lease or unit boundary line165..... feet.

County MontgomeryLease Name Butcher Well # 4Domestic well within 330 feet: ☐ yes ☒ noMunicipal well within one mile: ☐ yes ☒ no

Depth to Bottom of fresh water30..... feet

Lowest usable water formation

Depth to Bottom of usable water ...150..... feet

Surface pipe by Alternate: 1 ☐ 2 ☒

Surface pipe to be set ..40..... feet

Conductor pipe if any required

Ground surface elevation feet MSL

This Authorization Expires 1-31-86Approved By 7-31-85 JS

Must be filed with the K.C.C. five (5) days prior to commencing well
This card void if drilling not started within six (6) months of date received by K.C.C.

7-8-85-


RECEIVED
STATE CORPORATION COMMISSION

Important procedures to follow :

1. Notify District office before setting surface casing.
2. Set surface casing by circulating cement to the top.
3. File completion forms ACO-1 with K.C.C. within 10 days of well completion, following instructions on ACO-1, side 1, and including copies of wireline logs.
4. Notify District office 48 hours prior to old well workover or re-entry.
5. Prior to plugging, prepare a plugging plan, then obtain agreement from the appropriate district office for an approved plugging plan.
6. Submit plugging report (CP-4) to K.C.C. after plugging is completed.
7. Obtain an approved injection docket number before disposing of salt water.
8. Notify K.C.C. within 10 days when injection commences or terminates.
9. If an alternate 2 completion, cement in the production pipe from below any usable water to surface within 120 days of spud date.

JUN 08 1985
CONSERVATION DIVISION
Wichita, Kansas

**A Regular Section of Land
1 Mile = 5,280 Ft.**

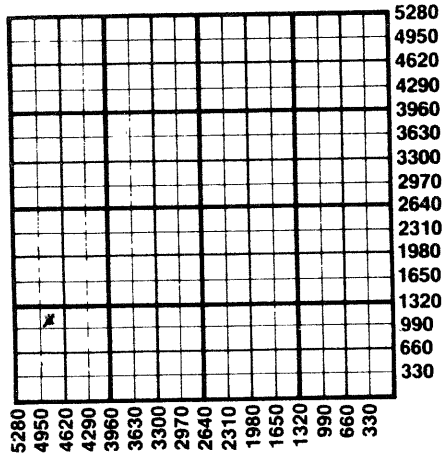

State Corporation Commission of Kansas
Conservation Division
200 Colorado Derby Building
Wichita, Kansas 67202
(316) 263-3238