

CARD MUST BE TYPED

State of Kansas

CARD MUST BE SIGNED

NOTICE OF INTENTION TO DRILL

(see rules on reverse side)

Starting Date 12 / 29 / 1986
month day year

API Number 15— 125-28,477-00-00

OPERATOR: License # 3090

N ~~1/4~~ NW NW Sec. 15 Twp. 35 S, Rg. 15 ~~West~~ ^X East

Name Bridwell Oil Company

Address Box 763

City/State/Zip Independence, KS 67301

Contact Person Bob Bridwell

Phone 316.331.8191

..... 4780 Ft. from South Line of Section
..... 4620 Ft. from East Line of Section

(Note: Locate well on Section Plat on reverse side)

CONTRACTOR: License # 5675

Nearest lease or unit boundary line 500 feet

Name McPherson Drilling Co.

County Montgomery

City/State Box 308, Cherryvale, KS 67335

Lease Name Newby Well # 7

Well Drilled For: Well Class: Type Equipment:

Ground surface elevation na feet MSL

Oil SWD Infield Mud Rotary

Domestic well within 330 feet: yes no

Gas Inj Pool Ext. Air Rotary

Municipal well within one mile: yes no

OWWO Expl Wildcat Cable

Depth to bottom of fresh water 150

Depth to bottom of usable water 250

If OWWO: old well info as follows:

Surface pipe by Alternate: 1 2

Operator

Surface pipe planned to be set 20

Well Name

Conductor pipe required

Comp Date Old Total Depth

Projected Total Depth 1240 feet

Formation Bartlesville

I certify that well will comply with K.S.A. 55-101, et seq., plus eventually plugging hole to KCC specifications.

Date .. 12/29/86 Signature of Operator or Agent *Elaine Burkam* Title as agent

For KCC Use:

Conductor Pipe Required feet; Minimum Surface Pipe Required 20 feet per Alt. *RJ*


This Authorization Expires 6-29-87 Approved By 12-29-86 *RJ*

Must be filed with the K.C.C. five (5) days prior to commencing well
 This card void if drilling not started within six (6) months of date received by K.C.C.

Important procedures to follow:

1. Notify District office before setting surface casing.
2. Set surface casing by circulating cement to the top.
3. File completion forms ACO-1 with K.C.C. within 90 days of well completion, following instructions on ACO-1, side 1, and including copies of wireline logs.
4. Notify District office 48 hours prior to old well workover or re-entry.
5. Prior to filing Intent, prepare a proposed plugging plan in case well is D & A, then obtain approval of plan when calling district office prior to setting surface pipe.
6. Submit plugging report (CP-4) to K.C.C. after plugging is completed.
7. Obtain an approved injection docket number before disposing of salt water.
8. Notify K.C.C. within 10 days when injection commences or terminates.

A Regular Section of Land
1 Mile = 5,280 Ft.

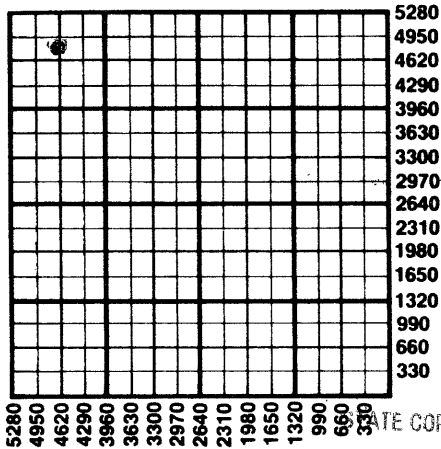

RECEIVED
 STATE CORPORATION COMMISSION

9. If an alternate 2 completion, cement in the production pipe from below any usable water to surface within 120 days of spud date.

DEC 29 1980

CONSERVATION DIVISION
 Wichita, Kansas

12-29-86

State Corporation Commission of Kansas
 Conservation Division
 200 Colorado Derby Building
 Wichita, Kansas 67202
 (316) 263-3238